
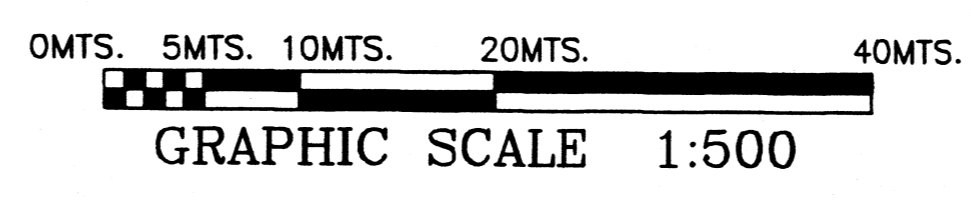


SCALE 1:500

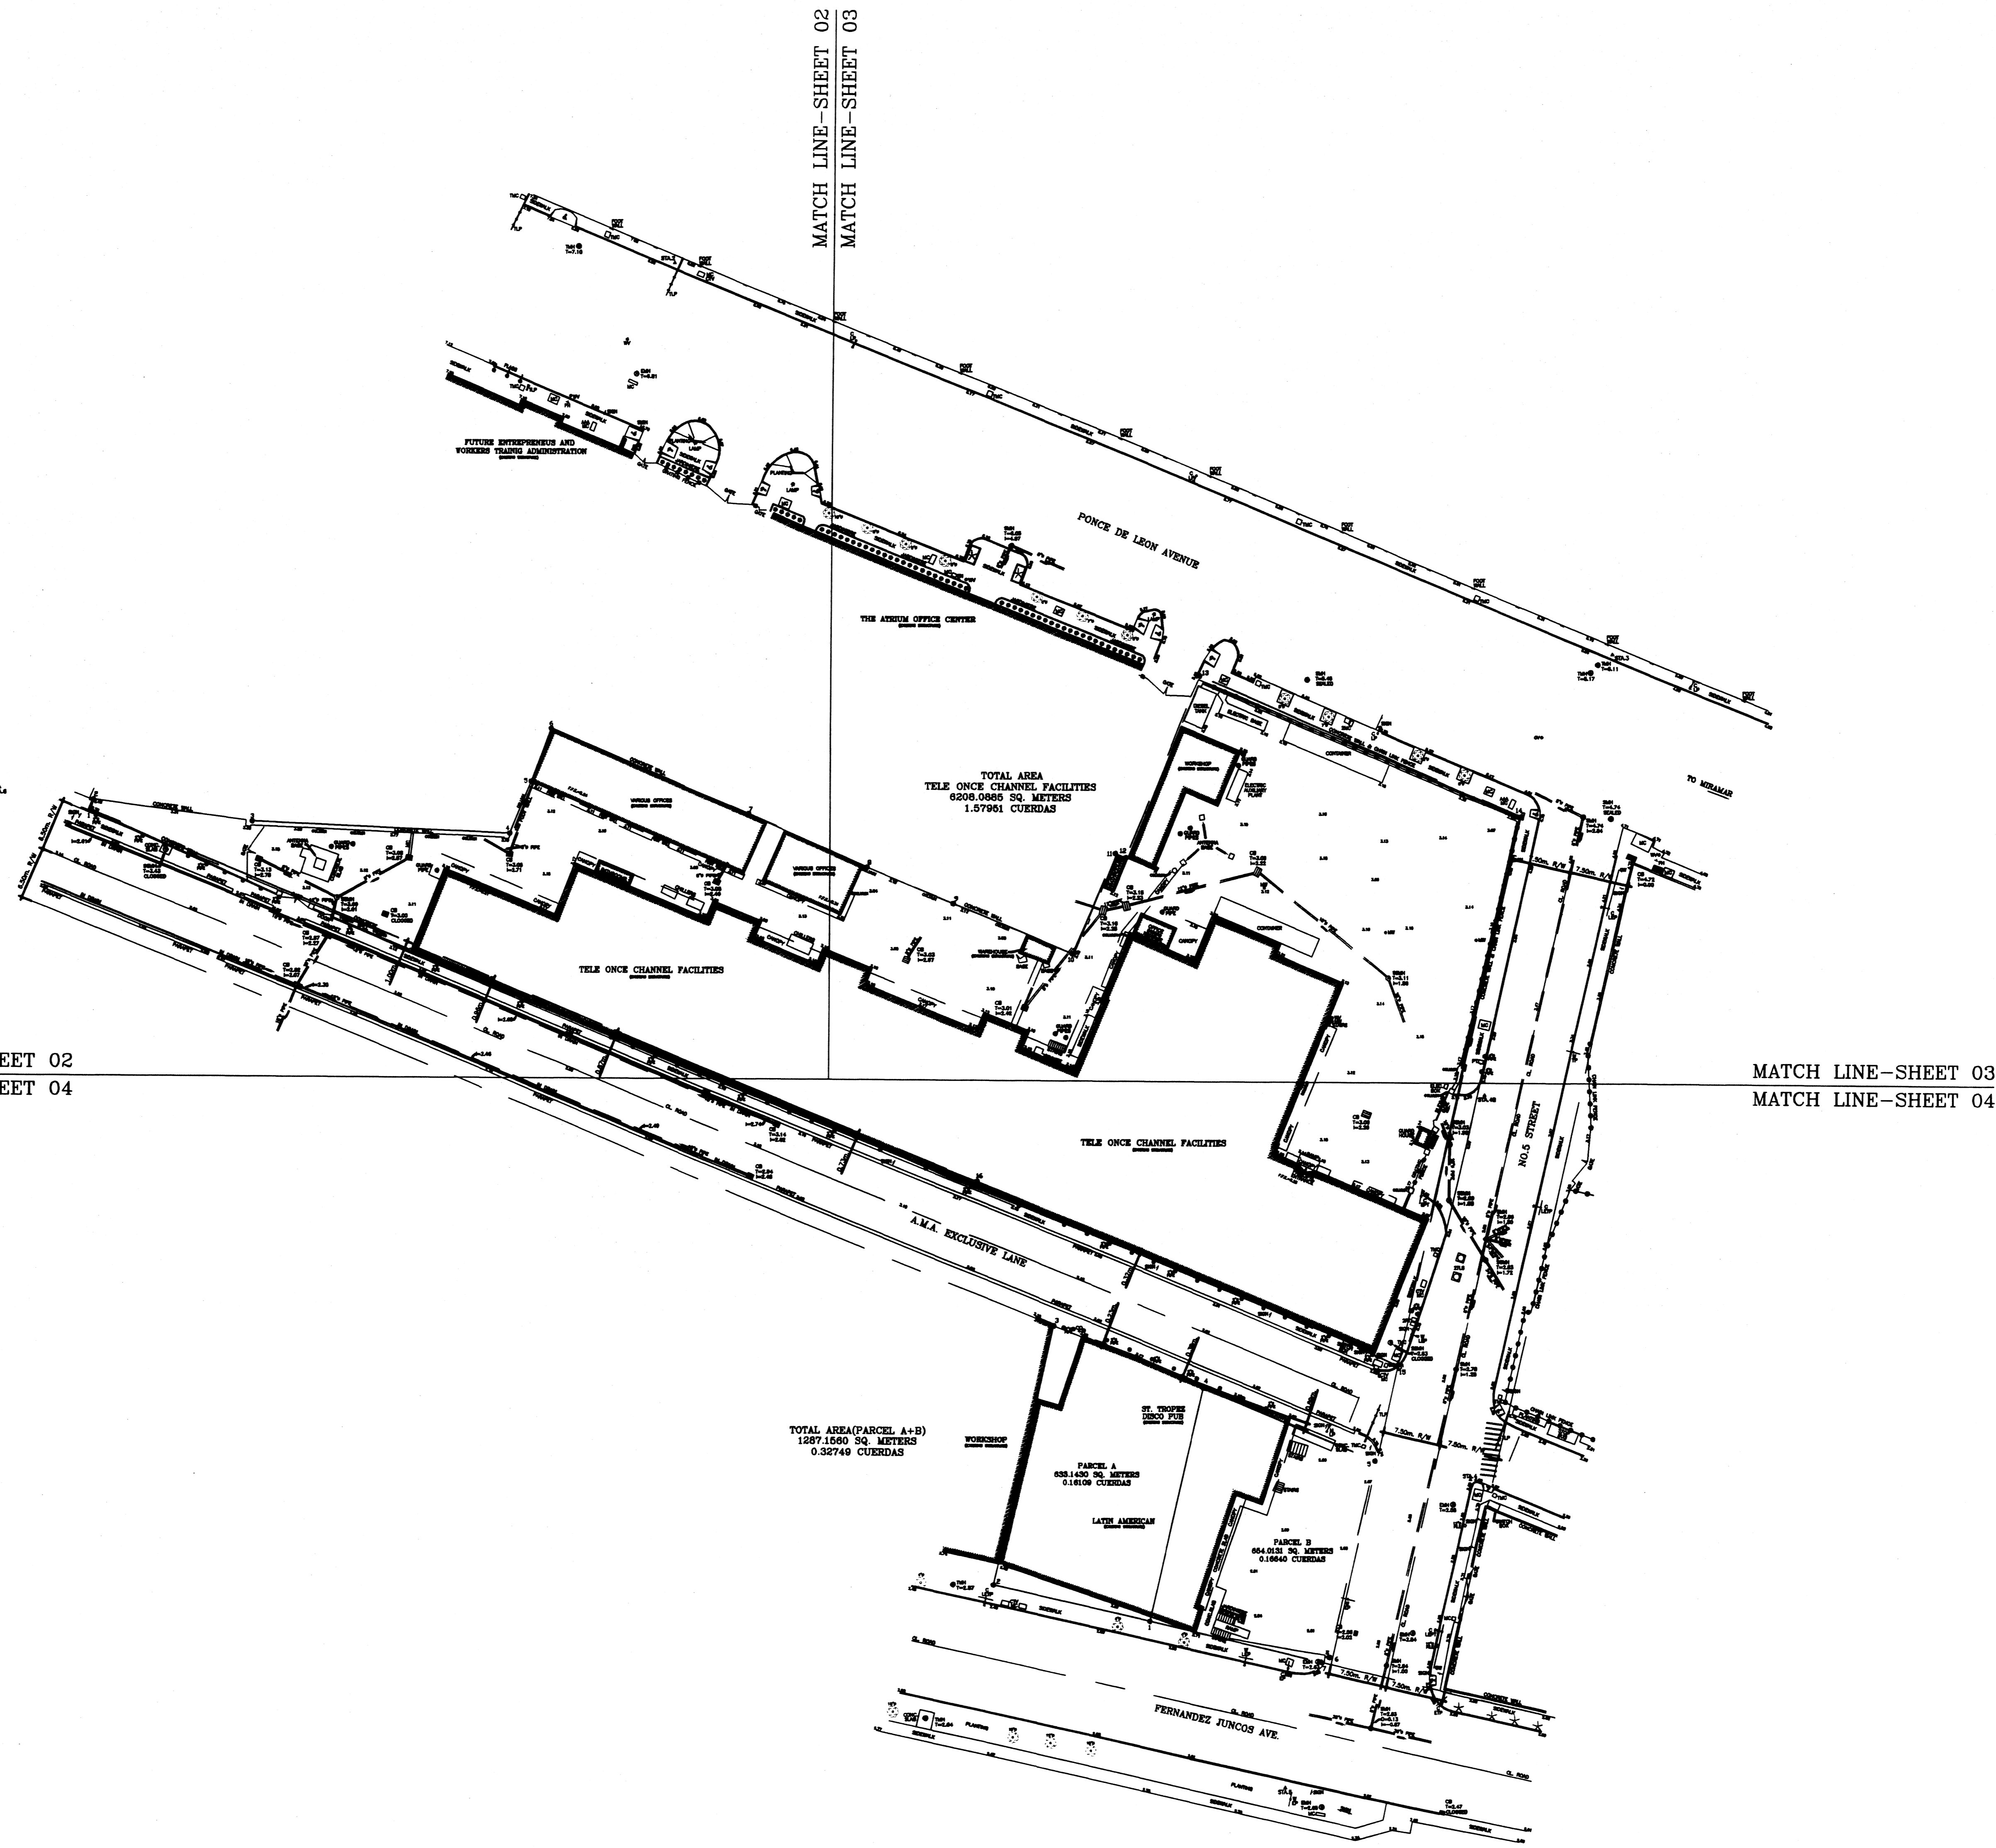

**ADVANCE COPY  
NOT FOR CONSTRUCTION**

THIS DRAWING IS THE PROPERTY OF FERNANDO GONZALEZ DIAZ ARCHITECT AND IS NOT TO BE REPRODUCED, EXHIBITED OR COPIED, IN WHOLE OR IN PART, WITHOUT THE WRITTEN CONSENT FROM THE ARCHITECT. IT IS NOT TO BE USED ON ANY OTHER PROJECT AND IS TO BE RETURNED UPON REQUEST. DIMENSIONS AND ALL OTHER CONDITIONS WHICH ARE NOT OTHERWISE DEFINED ON THIS DRAWING SHALL BE CONSIDERED AS HAVING THE SAME MEANING AS SIMILAR TERMINOLOGY AS SHOWN ON OTHER DRAWINGS FOR THIS PROJECT.

© FERNANDO GONZALEZ DIAZ, ARCHITECT

**PROJECT**  
SCHEMATIC DRAWINGS FOR:  
**SMALLWOOD PLACE**  
SAN JUAN, PUERTO RICO

CONSULTANT (S)

O.B. CONSTRUCTION, INC.  
Main Office  
27 NOV 2006  
**RECEIVED**

**REVISIONS**


TITLE:  
SURVEY & AS-BUILT PLAN

SHEET NO. **S1-1**  
of

DATE: JAN. 10, 2002  
DRAWN BY: G. RODRIGUEZ ORTIZ  
REV. BY: F. GONZALEZ DIAZ  
PLOT SCALE: As Noted  
FILE NAME: 134-S1-1.DWG  
PROJECT NO: 99-10-134