


PARKE 33  
4370 BARRETT BOULEVARD  
OKLAHOMA CITY, OK 73118

BUILDING I  
SUITES 4310  
268 SQ. FEET

216324



AS-BUILT FLOOR PLAN  
THIS IS NOT A SURVEY. ALL DIMENSIONS ARE  
APPROXIMATE AND SUBJECT TO FIELD VERIFICATION.

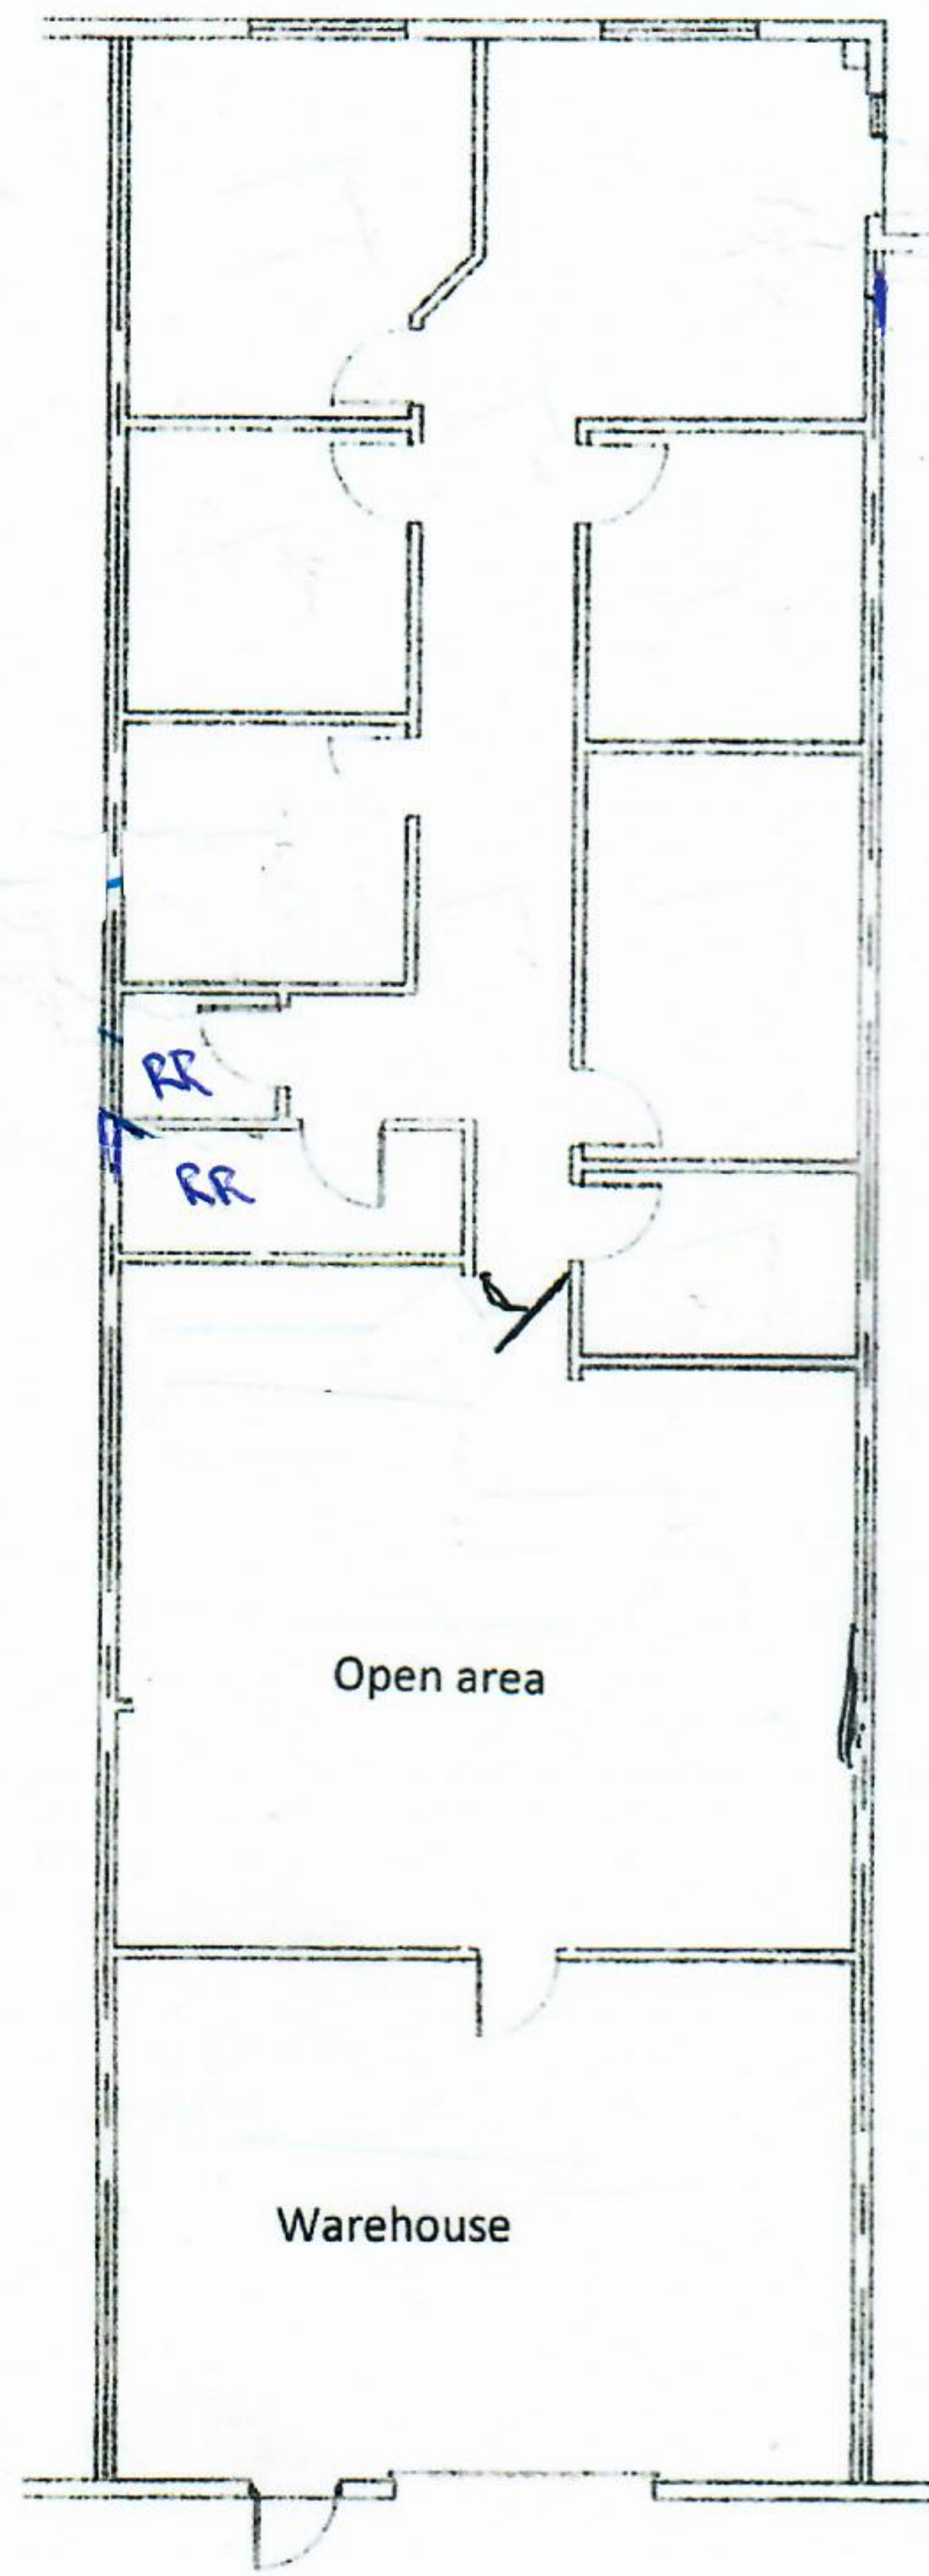

Open area

Warehouse

RR

RR