


Depiction of Premises Exhibit

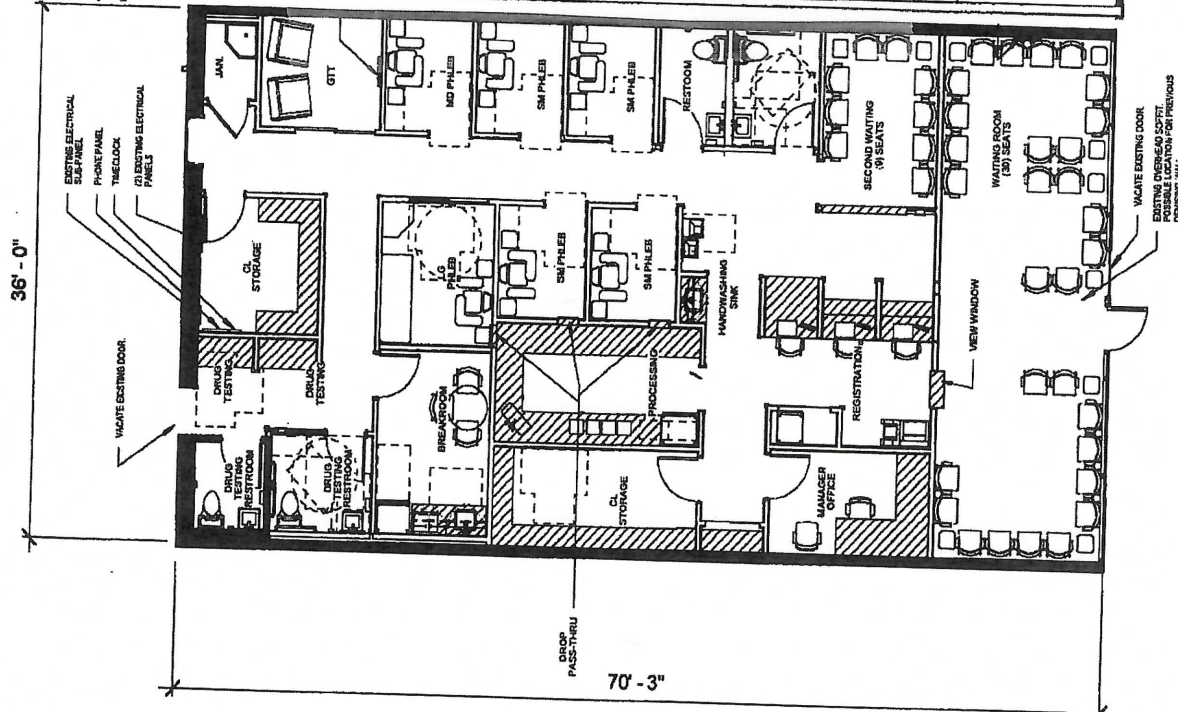


WOOD - 1060 W SR 434, Suite 100, Longwood, FL 32750

ECT # 69.6140.150
126

SCALE 1/8" = 1'-0"
02.11.13

Back of Building
Additional
Parking is Behind
Suites

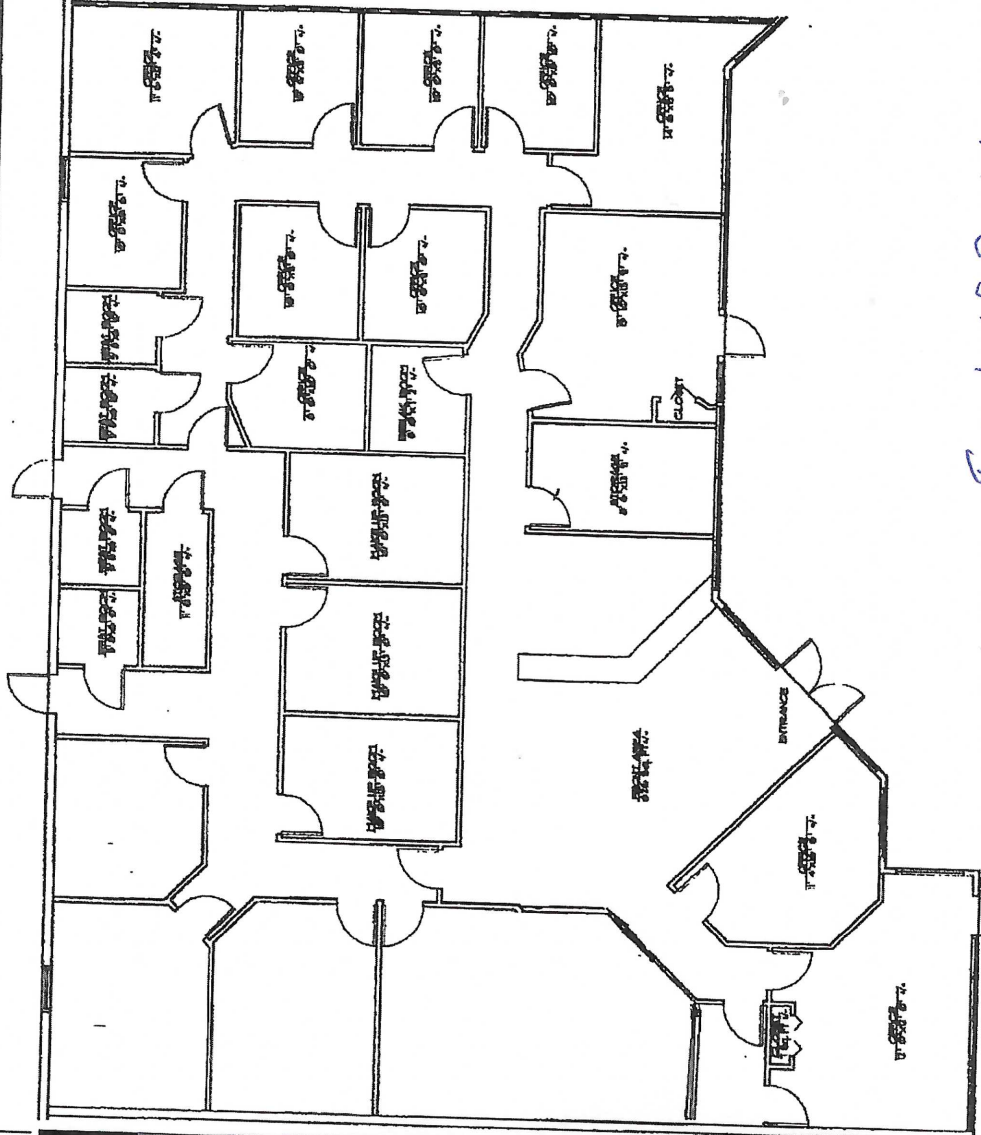

Front of Building

Rentable
ISLAND LAKE CENTER
201 EAST BAY DR
SUITE 136
1370 SQ. FT.
AS-BUILT FLOOR PLAN
FOR THE ABOVE PROPERTY. ALL DIMENSIONS ARE
BASED ON THE SURVEY. FOR INFO VISIT
0 4' 8'
1/8" = 1'-0"

Total
8,002 sq ft
Rentable