


SUITE 7
REFLECTED CEILING PLAN
SCALE: 1/4" = 1'-0"

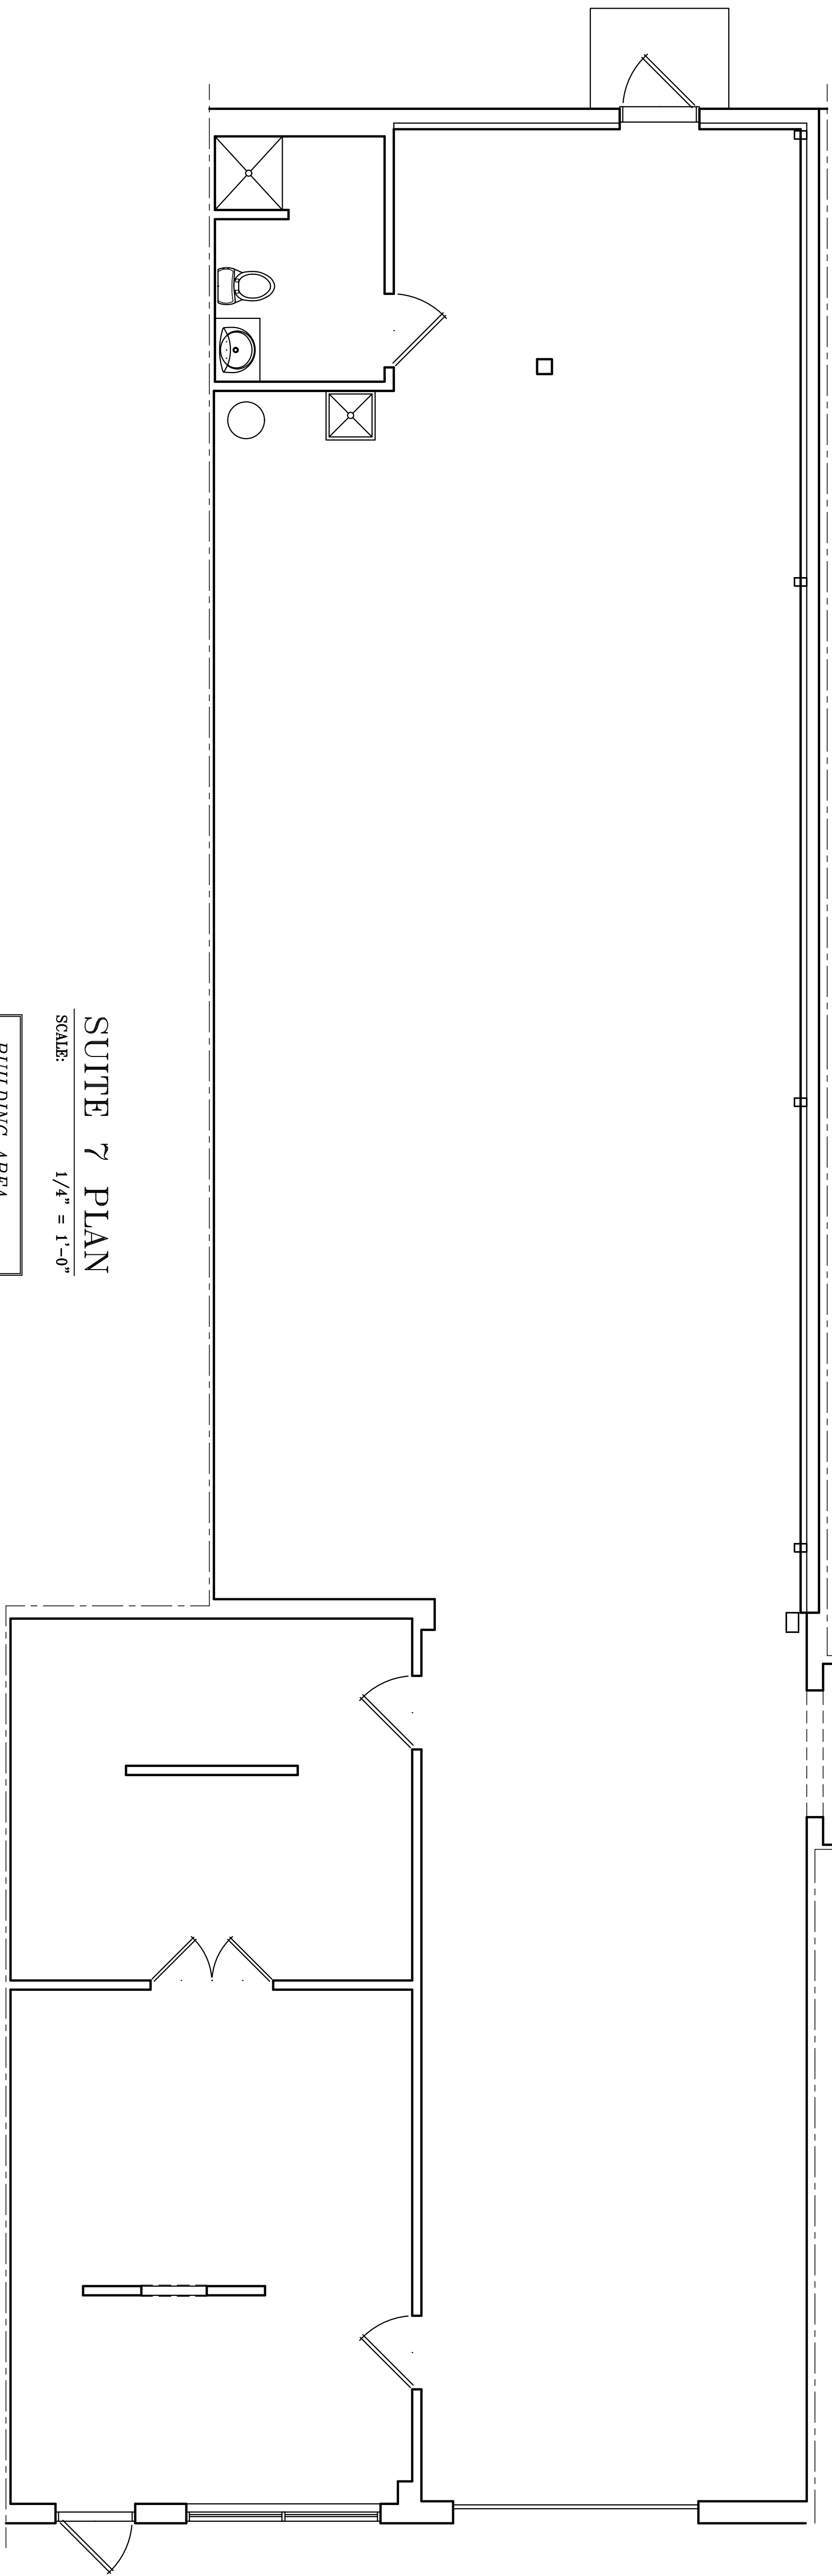

SUITE 7 PLAN
SCALE: 1/4" = 1'-0"


BUILDING AREA
SUITE 7 - 2,827 SQ. FT.

DATE	REV. NO.	DESCRIPTION

West & Associates
ARCHITECTS

4389 SHELBORNE DRIVE, DUNWOODY, GEORGIA 30338-6615 (770) 457-4495

SEAL

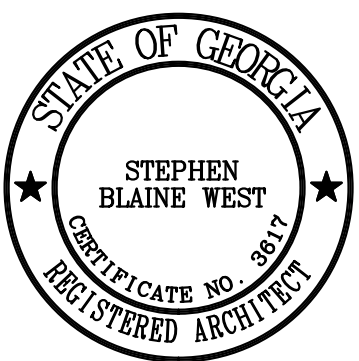

DRAWN

CHECKED

APPROVED

SHEET TITLE

SUITE 7 PLAN & REFLECTED CEILING PLAN

PROJECT NAME

AS-BUILT SURVEY
FOR 120 GLOSTER RD. - LAWRENCEVILLE, GA

REPRODUCTION RESTRICTION

This drawing is the property of the architect and shall not be reproduced or reproduced without the written permission of the architect.

PROJECT NO. DATE

2012110.00 6 JUNE 2012

SHEET NO.

A-7