


SUITE 11
REFLECTED CEILING PLAN

SCALE: 1/4" = 1'-0"

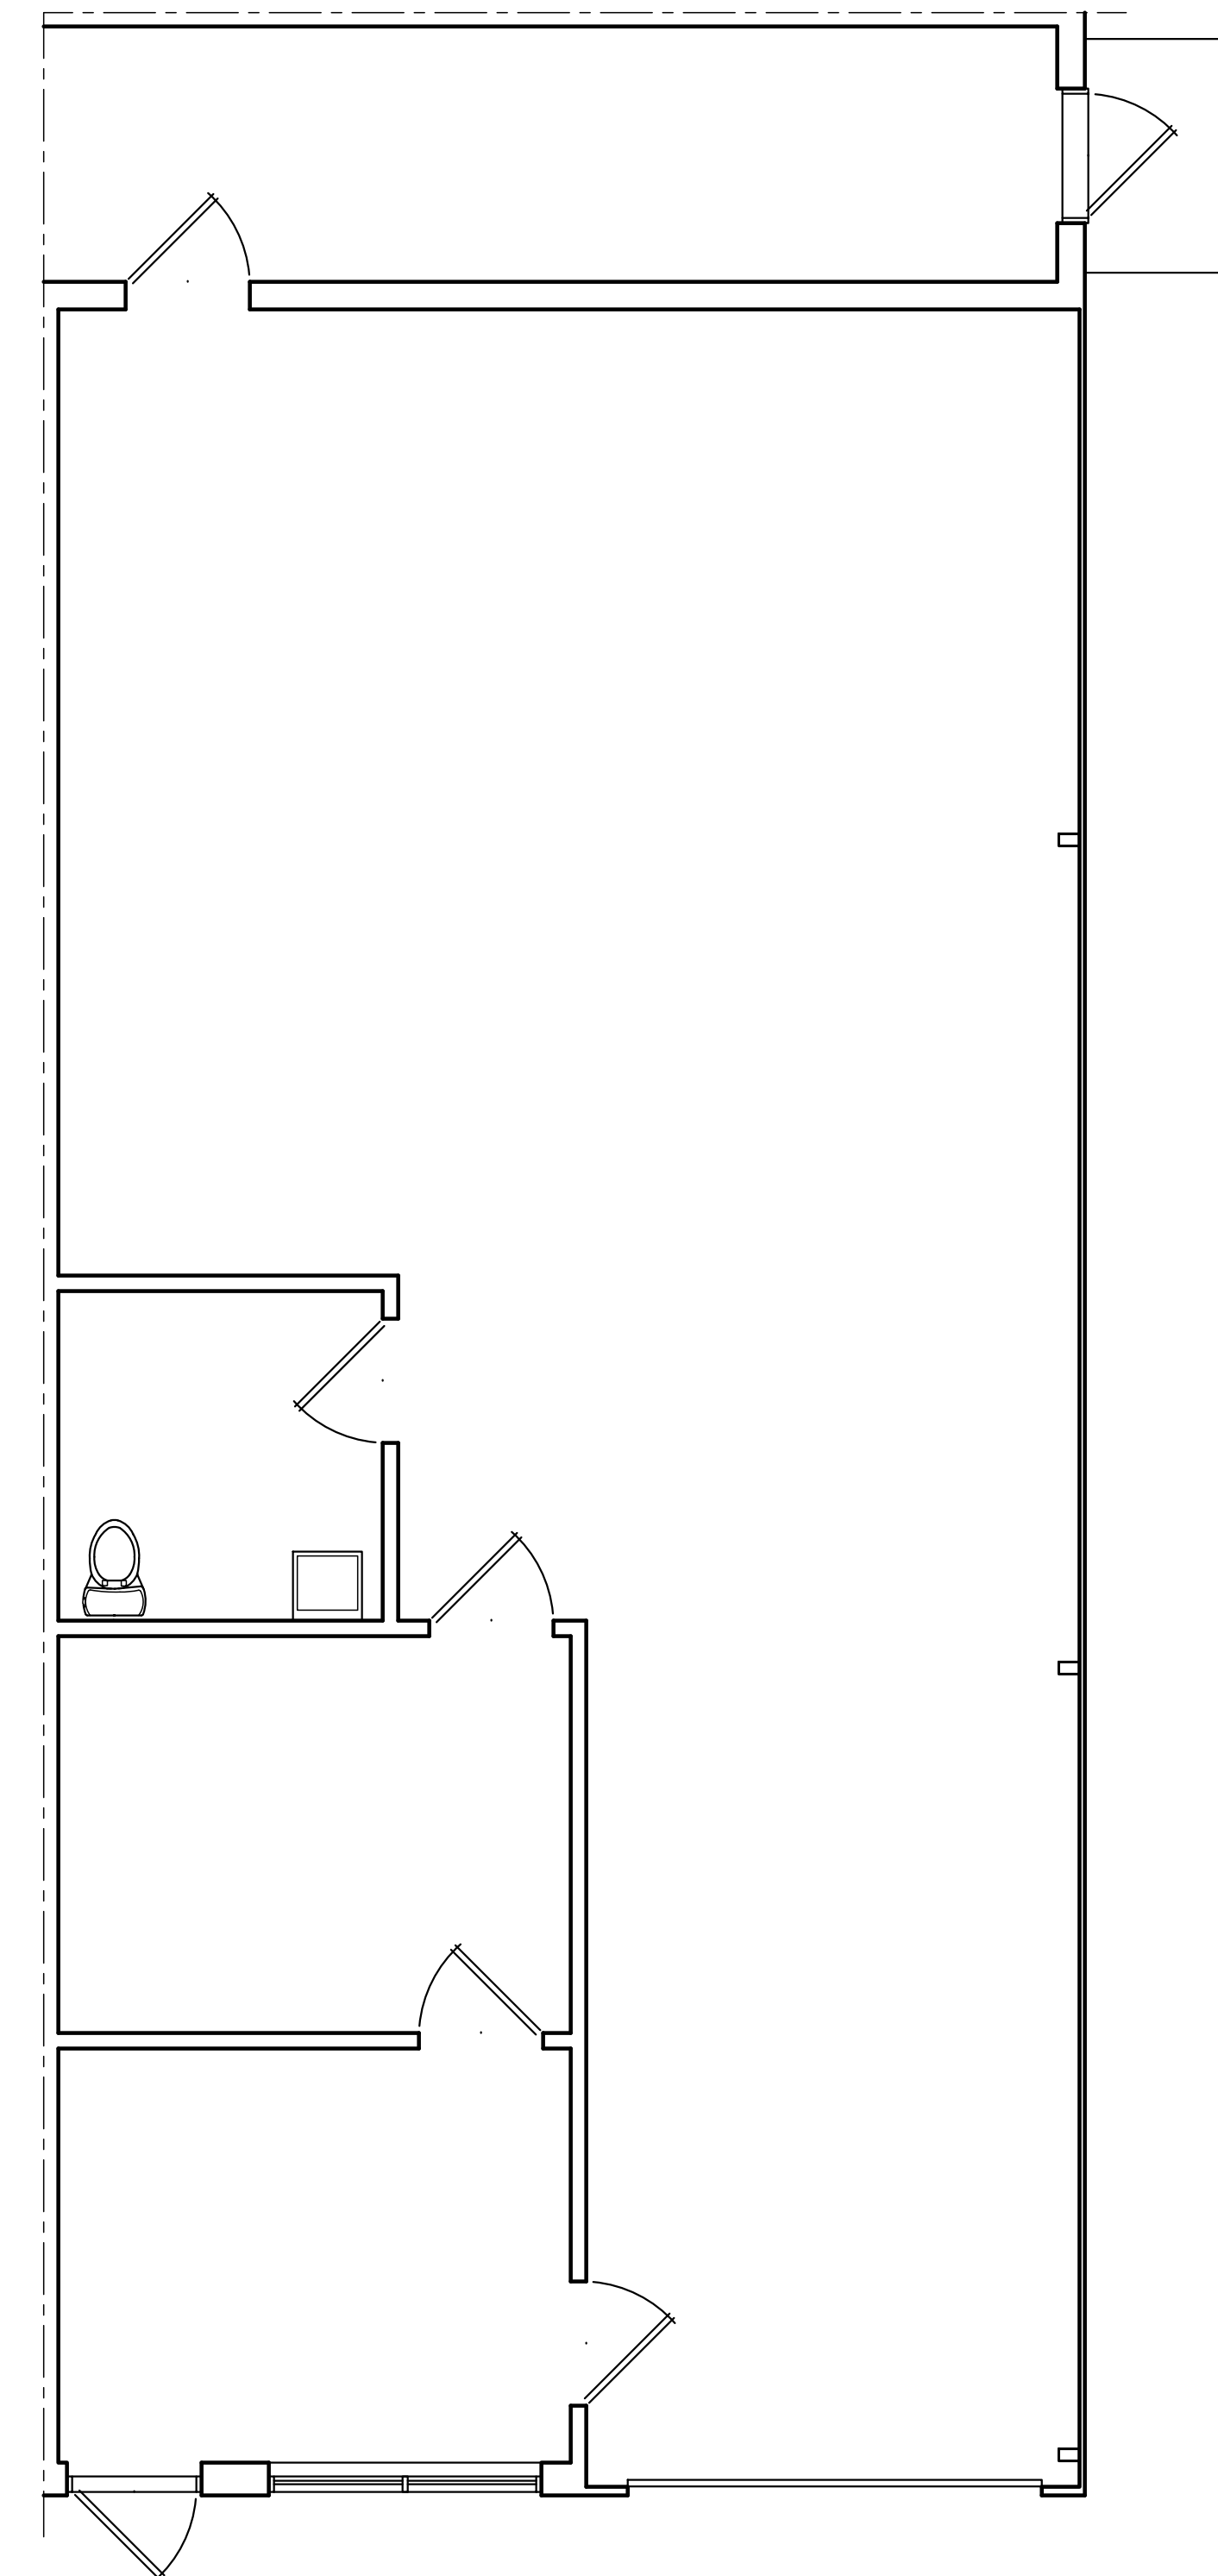


SUITE 11 PLAN

SCALE: 1/4" = 1'-0"

BUILDING AREA
SUITE 11 - 1,508 SQ. FT.

DATE	REV. NO.	DESCRIPTION

West & Associates
ARCHITECTS
4389 SHELDORNE DRIVE, DUNWOODY, GEORGIA 30338-8615 (770) 457-4485

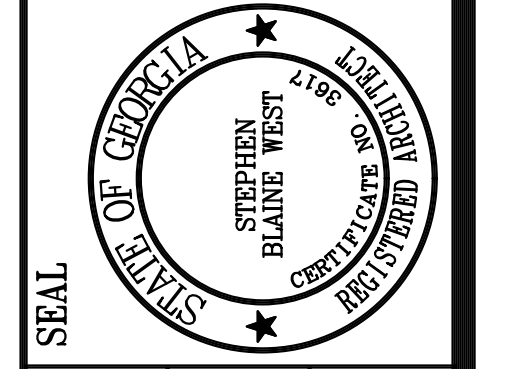

SEAL
DRAWN
CHECKED
APPROVED

SHEET TITLE
SUITE 11 PLAN & REFLECTED CEILING PLAN
PROJECT NAME
AS-BUILT SURVEY
FOR 120 GLOSTER RD. - LAWRENCEVILLE, GA

REPRODUCTION RESTRICTION
This drawing is the property of the Architect and may not be copied or reproduced without the written permission of the Architect.

PROJECT NO. 2012110.00
DATE 6 JUNE 2012

SHEET NO.

A-11