




QUORUM CENTER

- SUITE 16 AS-BUILT

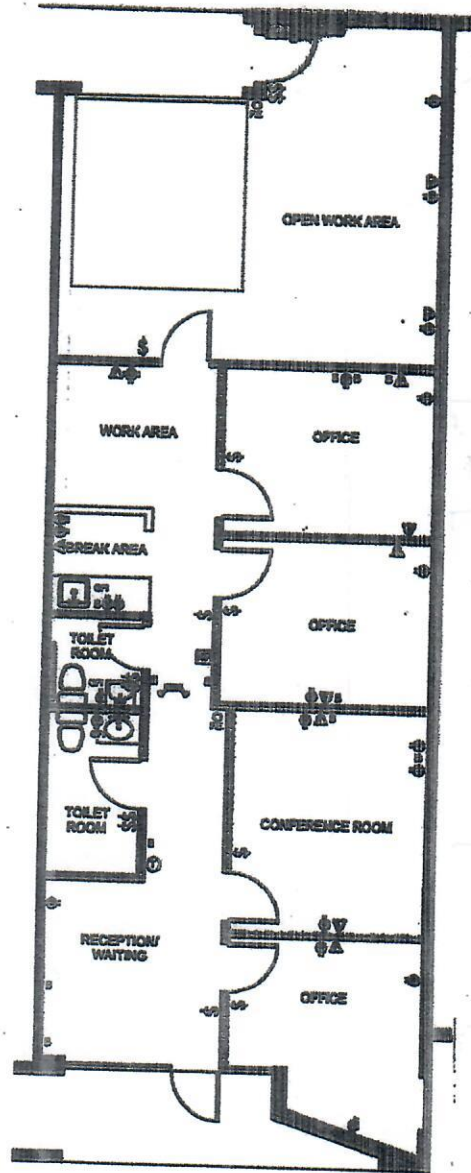

FLOOR PLAN
SCALE 1/8" = 1'-0"