


**SUITE 1  
REFLECTED CEILING PLAN**  
SCALE: 1/4" = 1'-0"

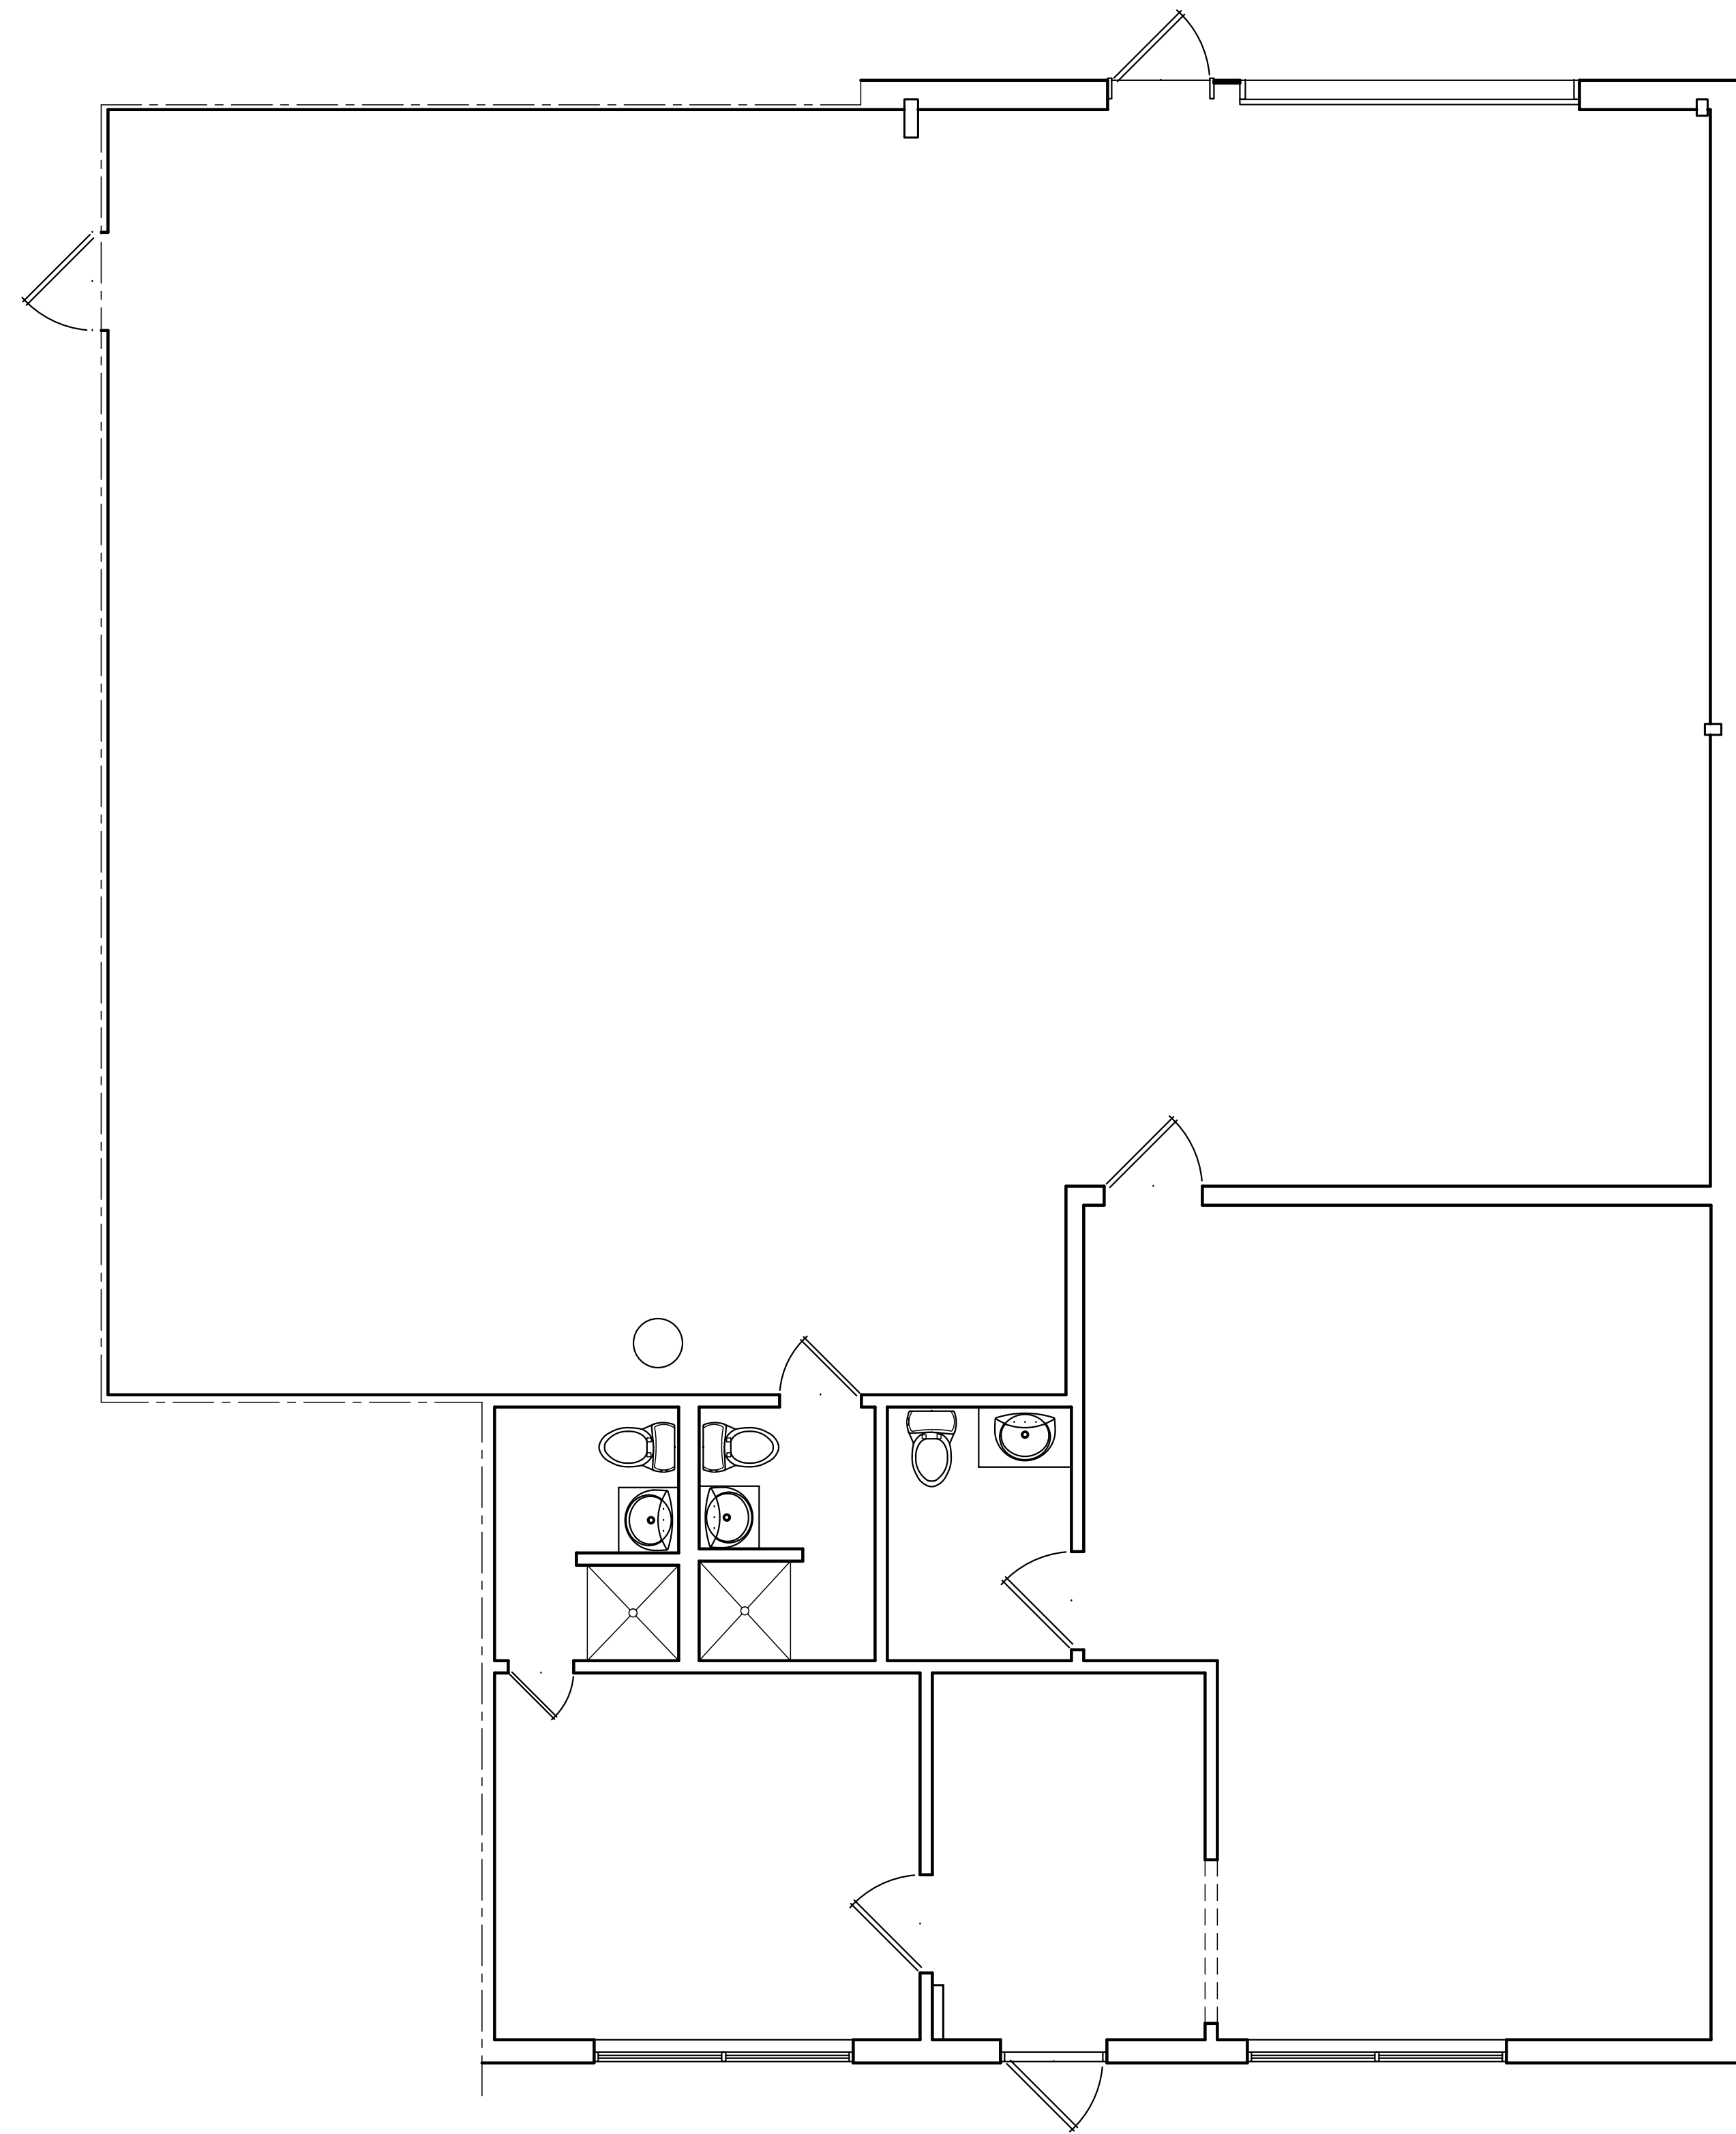


**SUITE 1 PLAN**  
SCALE: 1/4" = 1'-0"

BUILDING AREA  
SUITE 1 - 2,782 SQ. FT.

DATE	REV. NO.	DESCRIPTION

**West & Associates  
ARCHITECTS**

4389 SHELDORNE DRIVE, DUNWOODY, GEORGIA 30338-8615 (770) 457-4485

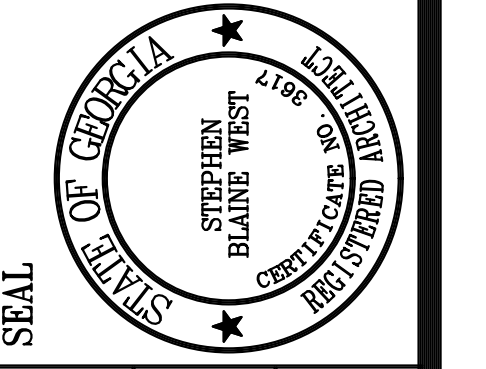

DRAWN  
CHECKED  
APPROVED

SHEET TITLE  
**SUITE 1 PLAN & REFLECTED CEILING PLAN**

PROJECT NAME  
**AS-BUILT SURVEY  
FOR 120 GLOSTER RD. - LAWRENCEVILLE, GA**

REPRODUCTION RESTRICTION  
This drawing is the property of the Architect and may not be copied or reproduced without the written permission of the Architect.

PROJECT NO. 2012110.00  
DATE 6 JUNE 2012

SHEET NO. **A-1**