

**FIRST FLOOR PLAN**


SCALE: 1/8" = 1'-0"

BUILDING AREA	
SUITE 1	- 2,782 SQ. FT.
SUITE 2	- 1,711 SQ. FT.
SUITE 3	- 1,516 SQ. FT.
SUITE 4	- 1,550 SQ. FT.
SUITE 5	- 2,864 SQ. FT.
SUITE 6	- 4,216 SQ. FT.
SUITE 7	- 2,827 SQ. FT.
SUITE 8	- 2,397 SQ. FT.
SUITE 9	- 1,500 SQ. FT.
SUITE 10	- 1,416 SQ. FT.
SUITE 11	- 1,508 SQ. FT.
TOTAL AREA - 24,287 SQ. FT.	

DATE	REV. NO.	DESCRIPTION
11/9/20	1	SUITE 9; MOVE OFFICE FROM BACK LEFT TO FRONT LEFT

**West & Associates**  
**ARCHITECTS**

4389 SHELDORNE DRIVE, DUNWOODY, GEORGIA 30338-8615  
(770) 457-4485

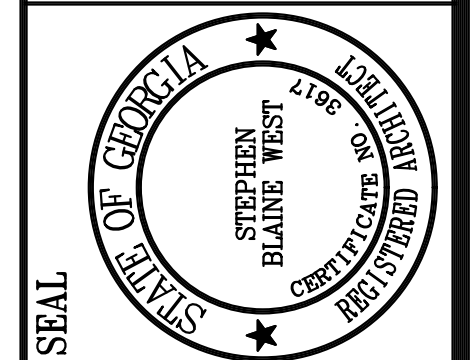

DRAWN: [ ] CHECKED: [ ] APPROVED: [ ]

SHEET TITLE: **FIRST FLOOR PLAN**  
PROJECT NAME: **AS-BUILT SURVEY FOR 120 GLOSTER RD. - LAWRENCEVILLE, GA**

**REPRODUCTION RESTRICTION**  
This drawing is the property of the Architect and may not be copied or reproduced without the written permission of the Architect.

PROJECT NO. 2012110.00 DATE 6 OCT. 2024

SHEET NO. A-0.1