

 
501 RH TODD


PARKING

8 ADA Parking


500 Parking

508 TOTAL



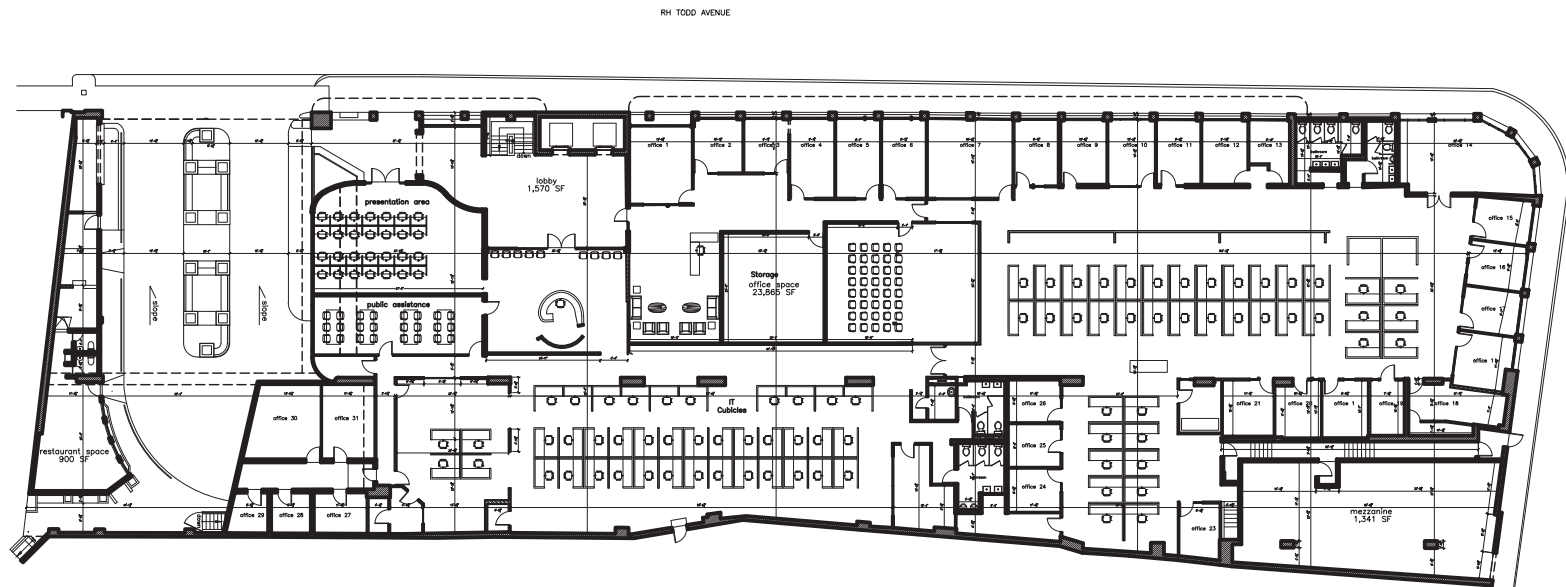


first floor "as built"

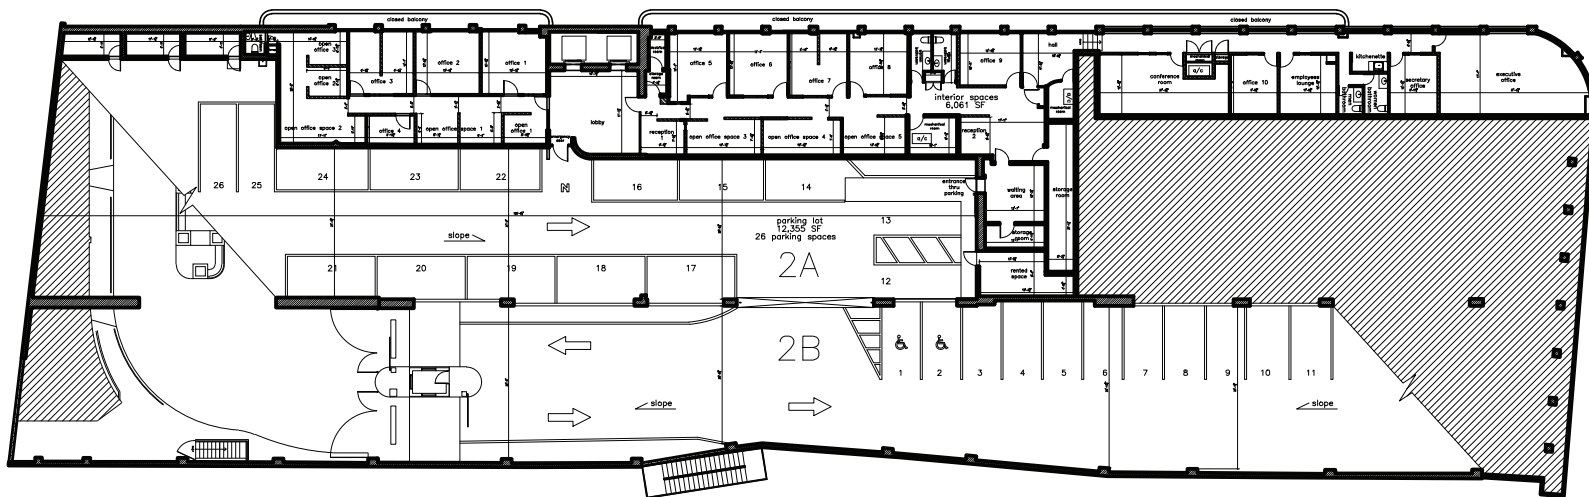

Keyplan Spaces 1-26

- 2 ADA Parking
- 26 Parking
- 80 TOTAL

2A - 2B Floor

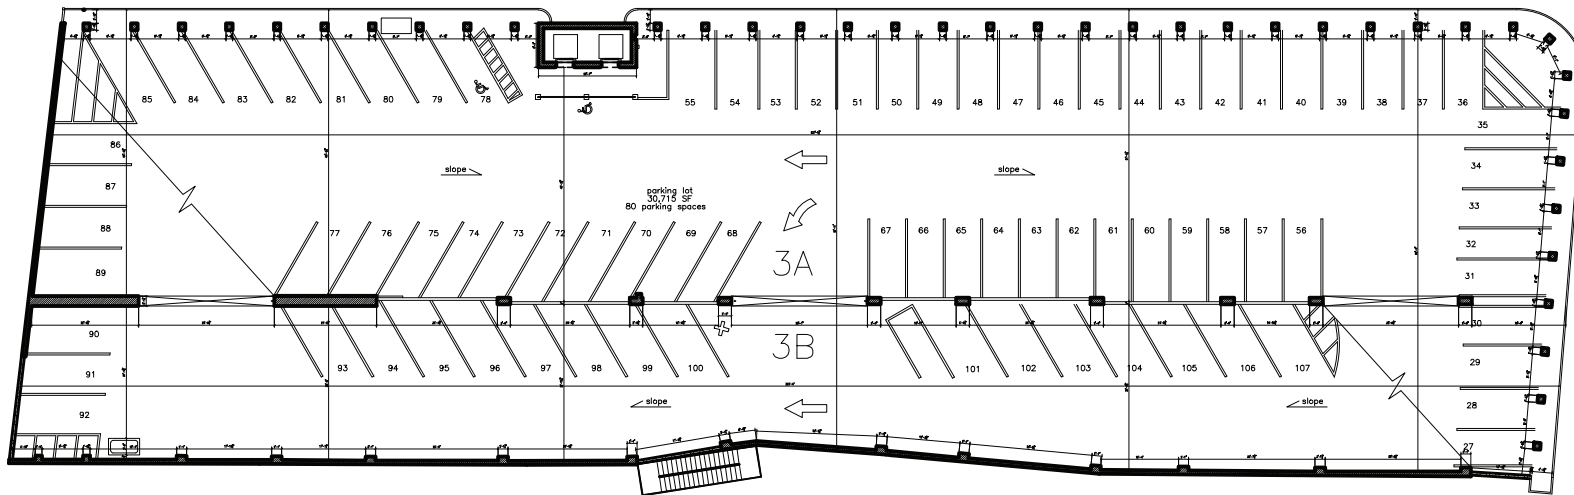


3A-3B floor plan as built
Scale 1/8" = 1'-0"


Keyplan Spaces 27 -107:

- 1 ADA Parking
- 79 Parking
- 80 TOTAL

3A - 3B Floor

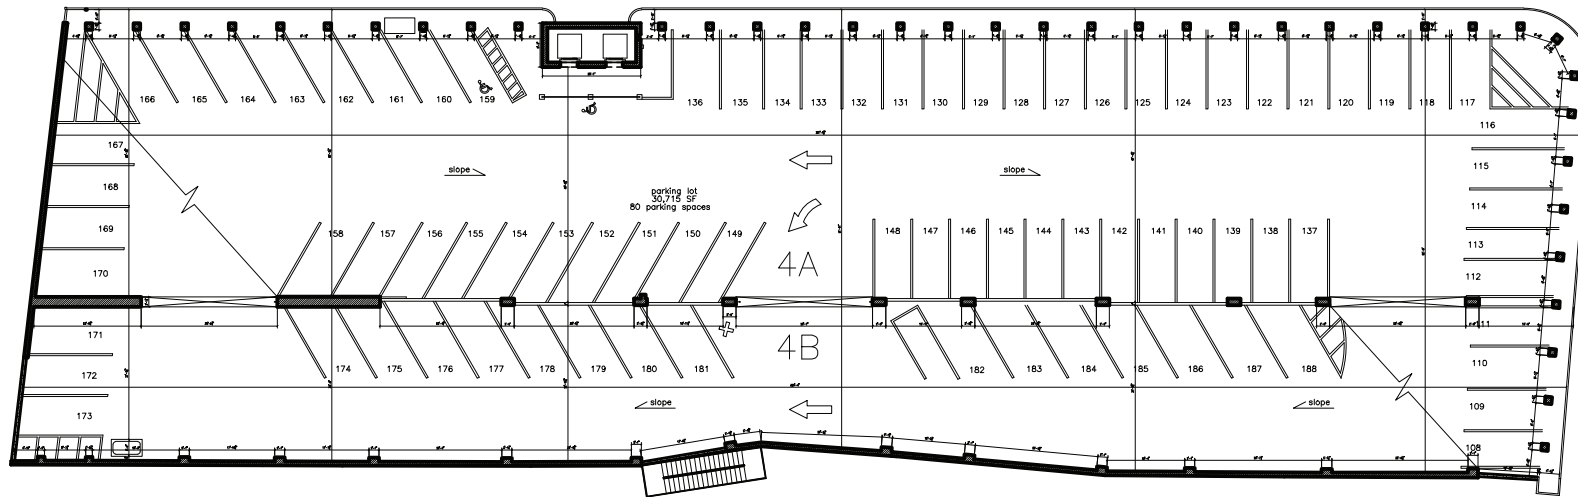


4A-4B floor plan as-built
Scale 1/8" = 1'-0"

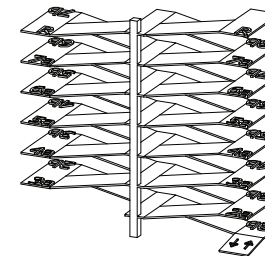

Keyplan Spaces 108 - 188:

- 1 ADA Parking
- 79 Parking
- 80 TOTAL

4A - 4B Floor

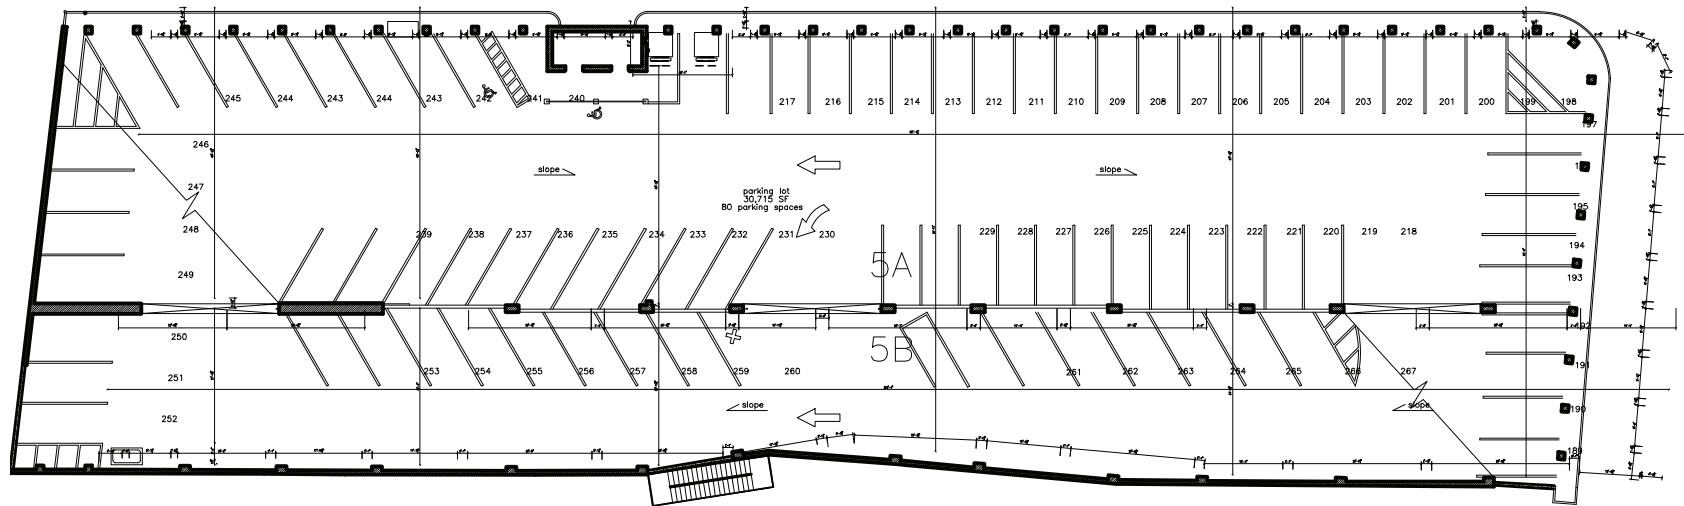


5A-5B floor plan as built
Scale: 1/8" = 1'-0"

Keyplan Spaces 189 - 267:

- 1 ADA Parking
- 79 Parking
- 80 TOTAL

5A - 5B Floor

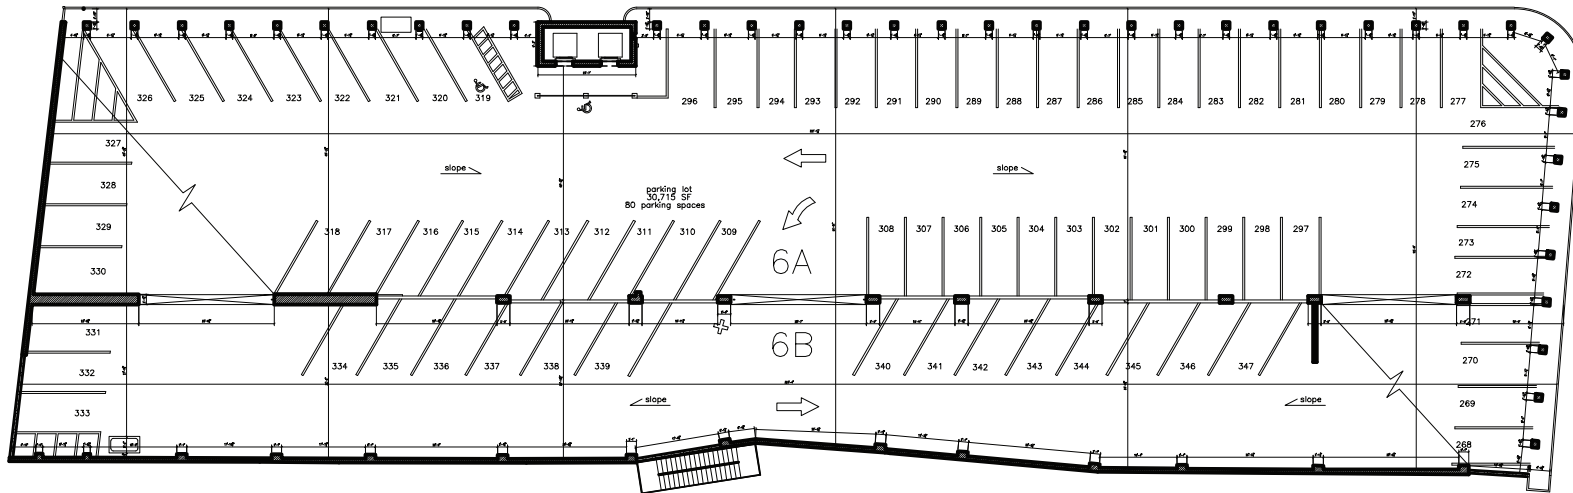


6A-6B floor plan as built
Scale 1/8" = 1'-0"

Keyplan Spaces 268 - 347:

- 1 ADA Parking
- 79 Parking
- 80 TOTAL

6A - 6B Floor

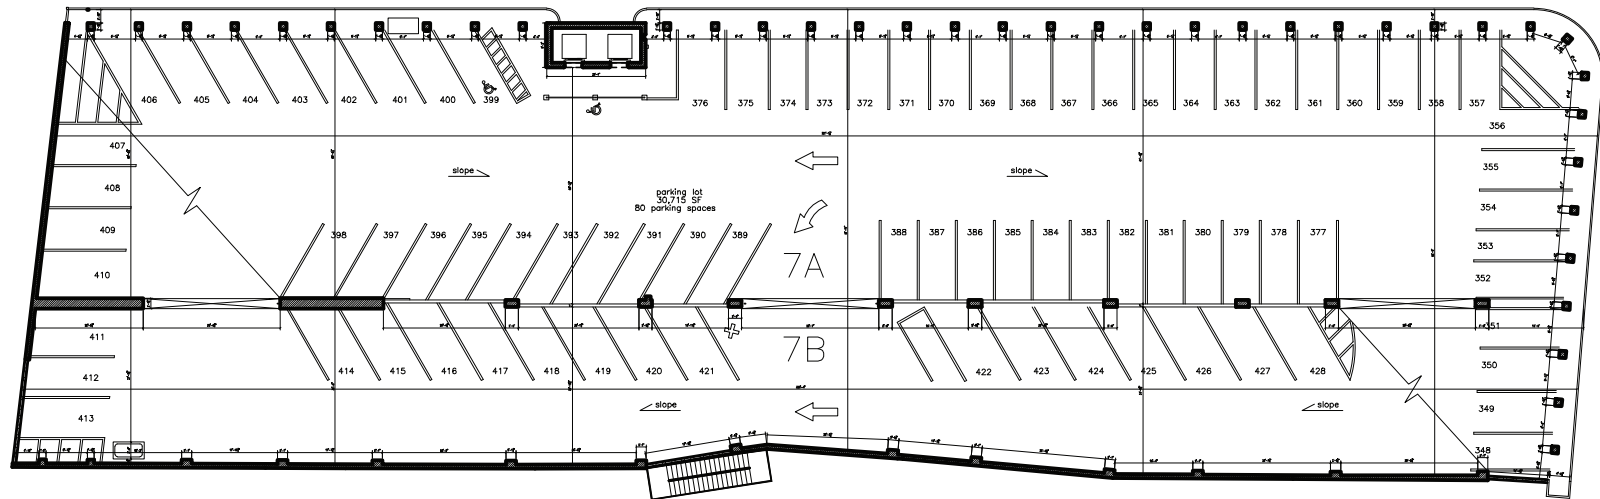


7A-7B floor plan as built
Scale: 1/8" = 1'-0"

Keyplan 348 - 428:

- 1** ADA Parking
- 79** Parking
- 80** TOTAL

7A - 7B Floor

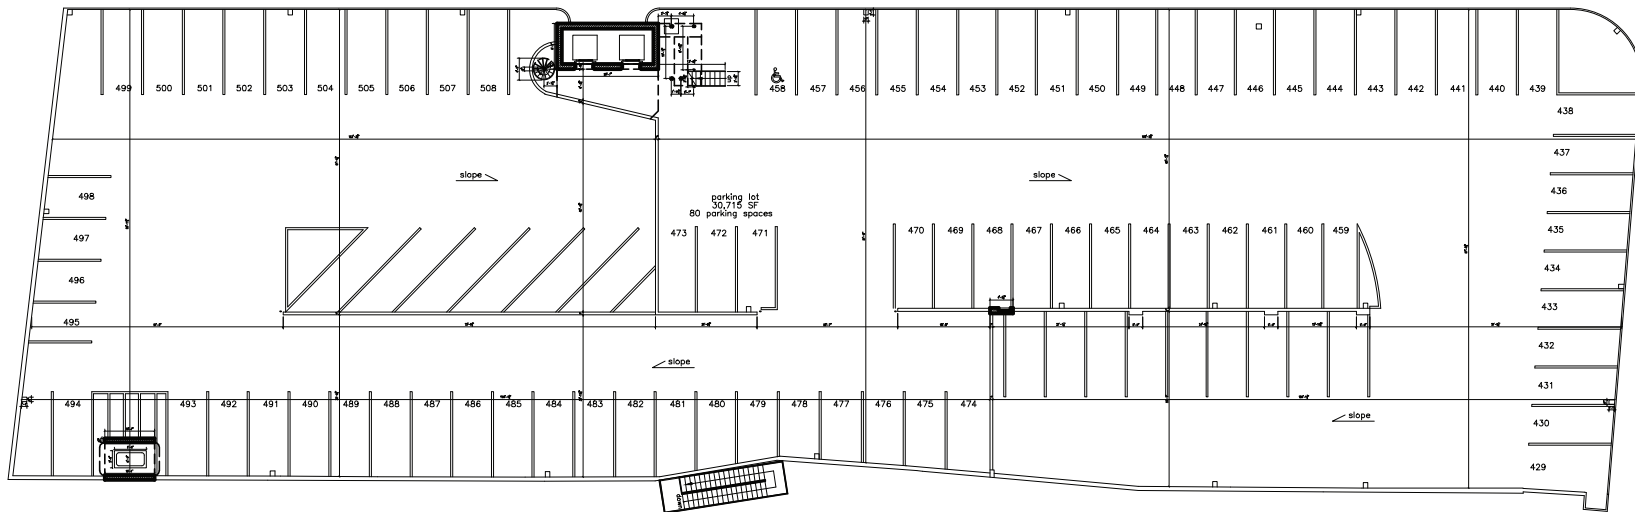

8B-R rooftop floor plan as built
SCALE 1/8" = 1'-0"

Keyplan Spaces 429 - 508:

- 1 ADA Parking
- 78 Parking
- 80 TOTAL

8B - Roof Floor