


DISREGARD IF ALREADY FINALED

Please call & schedule final elect insp. & final pdg. insp. separately from building insp. call 8/20/99


"NO STOCKING OF BUILDING ALLOWED UNTIL INSPECTION DEPT. HAS ISSUED CERTIFICATE OF OCCUPANCY"

APPROVED  
 BLDG DEPT.  
 CITY OF ALTA MONTE SPRINGS, FLA  
 DATE: 7/21/91  
 BLDG OFFICIAL: [Signature]  
 FIRE OFFICIAL: [Signature]  
 PERMIT NO.: 8584-81  
 ADDRESS: 300 [unclear] Rd  
 THIS APPROVAL DOES NOT GRANT PERMISSION TO VIOLATE ANY APPLICABLE CODE. KEEP THIS PLAN ON JOB AT ALL TIMES.

BLDG  
 PLANNING AND ZONING DEPARTMENT  
 APPROVED  
 [Signature]  
 OFFICE COPY

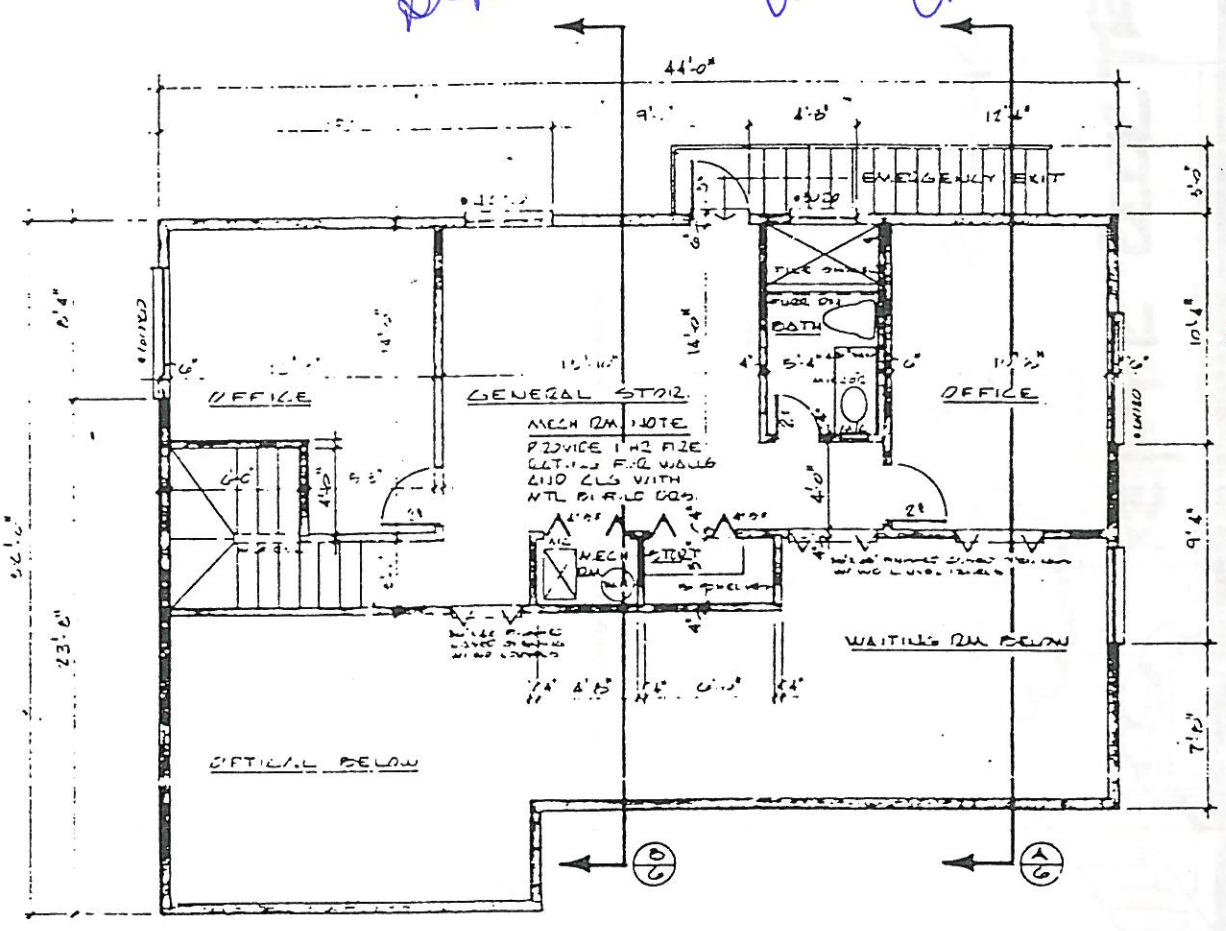

SECOND FLOOR

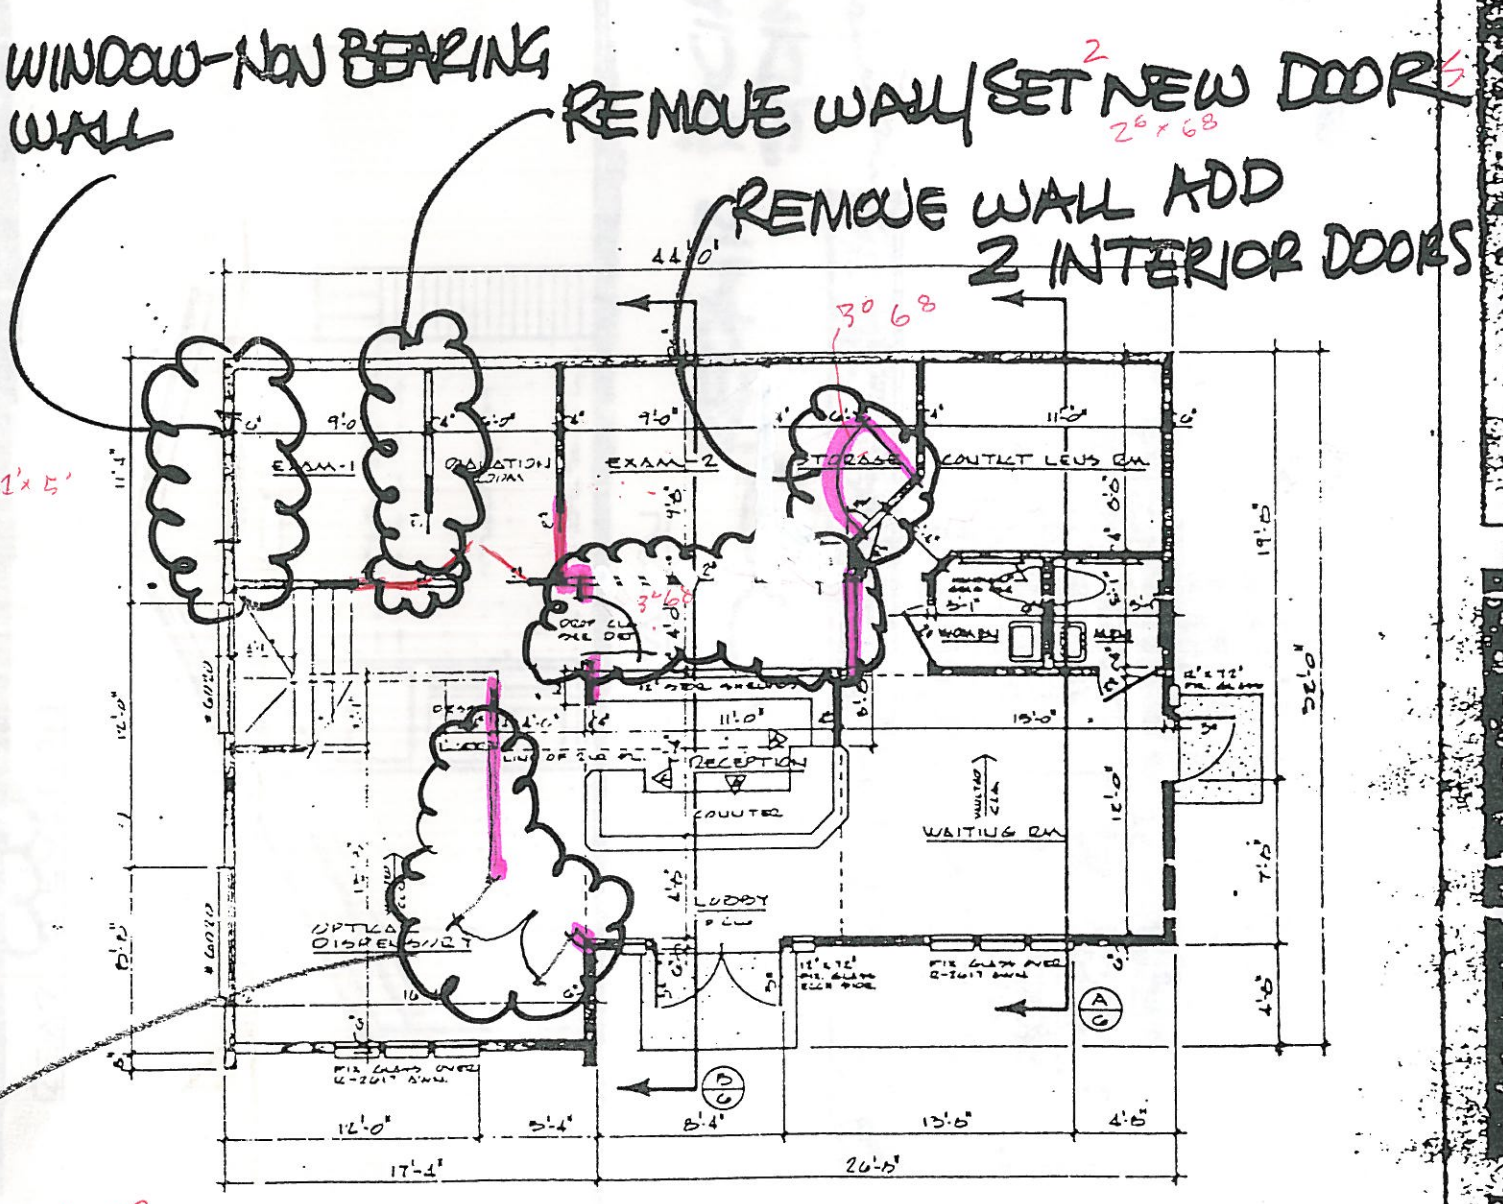

FIRST FLOOR

FLOOR PLAN  
SCALE - 1/4" = 1'-0"

INTERIOR CHANGES

APPROVED AS NOTED  
BUILDING INSP. DEPT.  
ALTA MONTE SPRINGS  
CHANGES TO APPROVED PLANS MUST BE  
CLEARED WITH THE BUILDING INSPECTOR

SQ. FOOTAGE  
FIRST FLOOR AREA 1200  
SECOND FLOOR AREA 640  
2040 SQ. FT.

NOTE: SIGN PERMIT  
REQUIRED

NOTICE DO NOT CONNECT OR  
DISCHARGE WATER FROM ANY  
AIR CONDITIONER OR HEAT PUMP  
INTO SANITARY SEWER SYSTEM

SOIL POISONING  
REQUIRED

INSULATION INSPECTION  
REQUIRED  
AFTER FRAME

Inspector will not be held  
liable for permit to proceed  
in a permanent and permanent  
position and structural approval  
the drawings and numbers, etc.  
the drawings.