

THE GENERAL CONTRACTOR SHALL VERIFY ALL DIMENSIONS, LEVELS AND CONDITIONS AT THE SITE PRIOR TO THE COMMENCEMENT OF WORK. ANY DISCREPANCIES, OMISSIONS OR CHANGES IN THE PLANS SHALL BE NOTIFIED TO THE ARCHITECT BEFORE COMMENCEMENT OF ANY WORK. NO CHANGES OR MODIFICATIONS TO THE PLANS SHALL BE MADE WITHOUT THE ARCHITECT'S WRITTEN CONSENT. THE ARCHITECT SHALL BE SOLELY RESPONSIBLE FOR THE ACCURACY OF THE PLANS.

ALL DESIGN, DRAWINGS AND COPIES ISSUED BY THE ARCHITECT ARE PROPERTY OF THE ARCHITECT AND CANNOT BE USED OR REPRODUCED IN ANY OTHER MANNER OR PLACE, EXCEPT FOR THE PURPOSE OF ITS DESIGN INTENT.

IF FOR ANY REASON PART OR ALL OF THE ARCHITECT'S DESIGN IS USED WITHOUT HIS/HER CONSENT, THE PARTIES INVOLVED SHALL PAY THE ARCHITECT FEE AS REQUIRED IN FEE.

AT NO TIME SHALL THE GENERAL CONTRACTOR UTILIZE FOR CONSTRUCTION ANY DRAWING ISSUED TO HIM/HER PRIOR TO CONSTRUCTION (UNLESS SIGNED AND SEALED BY BOTH "TAMPE" (REGULATIONS AND PERMITS ADMINISTRATION) AND THE ARCHITECT).

SAN JORGE 373

SAN JUAN, P.R. 00936

CONSULTANTS:

OWNER:

STRUCTURAL:

ELECTRICAL:

Mechanical:

LANDSCAPE:

SHEET TITLE:

SECOND FLOOR PLAN

PLOT SCALE: 1/4"=1'-0"

DATE: august/2016


DESIGN BY: R.PEREZ

LEGEND:

EXISTING STRUCTURE WALLS

PROPOSED CONCRETE WALLS

PROPOSED BLOCK WALLS

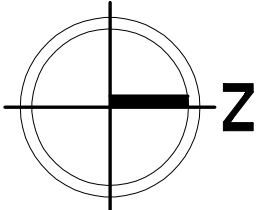

second floor "as built"

SCALE 1/4" = 1'-0"