


basement / parking level "as built"

SCALE 1/4" = 1'-0"

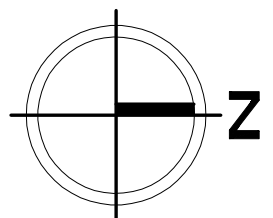

LEGEND:
EXISTING STRUCTURAL WALLS
PROPOSED GYPSUM WALLS
PROPOSED BLOCK WALLS

THE GENERAL CONTRACTOR SHALL VERIFY ALL DIMENSIONS, LEVELS AND CONDITIONS AT THE SITE PRIOR TO THE COMMENCEMENT OF WORK. ANY DISCREPANCIES, OMISSIONS OR CHANGES TO THE PLANS SHALL BE NOTIFIED TO THE ARCHITECT BEFORE COMMENCEMENT OF ANY WORK. PRICE AND SCHEDULING OMISSIONS ETC. ARE NOT NOTIFIED TO THE ARCHITECT. THE GENERAL CONTRACTOR SHALL BE FULLY RESPONSIBLE.

ALL DESIGN, DRAWINGS AND COPIES ISSUED BY THE ARCHITECT ARE PROPERTY OF THE ARCHITECT AND CANNOT BE USED OR REPRODUCED IN ANY OTHER MANNER OR PLACE, EXCEPT FOR THE PURPOSES OF ITS DESIGN INTENT.

IF FOR ANY REASON PART OR ALL OF THE ARCHITECT'S DESIGN IS USED WITHOUT THE ARCHITECT'S CONSENT, THE PARTIES INVOLVED SHALL PAY THE ARCHITECT FEE AS REQUIRED IN FEE.

AT NO TIME SHALL THE GENERAL CONTRACTOR UTILIZE FOR CONSTRUCTION ANY DRAWING ISSUED TO THE OWNER PRIOR TO CONSTRUCTION (UNLESS SIGNED AND SEALED BY BOTH "TAMPE" (REGULATIONS AND PERMITS ADMINISTRATION) AND THE ARCHITECT).

SAN JORGE 373

SAN JUAN, P.R. 00936

CONSULTANTS:

OWNER:
STRUCTURAL:
ELECTRICAL:
MECHANICAL:
LANDSCAPE:

SHEET TITLE:
BASEMENT LEVEL

PLOT SCALE:
1/4"=1'-0"

DATE:
august/2016

DESIGN BY:
R.PEREZ

ASB-103