



RAMEY STORAGE PROPERTY FOR LEASE

CIRCLE E #G1, RAMEY BASE, AGUADILLA, PUERTO RICO

PROPERTY DETAILS

Densely populated area surrounded by many supporting commercial, industrial and residential uses, specifically, the Rafael Hernandez Airport. In close proximity to several car rental companies, pharmacies, gas stations, fast food restaurants and hotels, as well as the University of Puerto Rico-Aguadilla campus, Ramey school, Lufthansa and Honeywell aerospace.

COORDINATES

18.49892109, -67.13087584

SITE AREA

2,767.5 square meters

BUILDING AREA

Bldg A: 3,692 square feet

Bldg B: 2,652 square feet


Total: 6,344 square feet

ZONING


(R-I) Intermediate Residential

*Property is surrounded by C-1 uses

CIRCLE E #G1, RAMEY BASE, AGUADILLA, PUERTO RICO

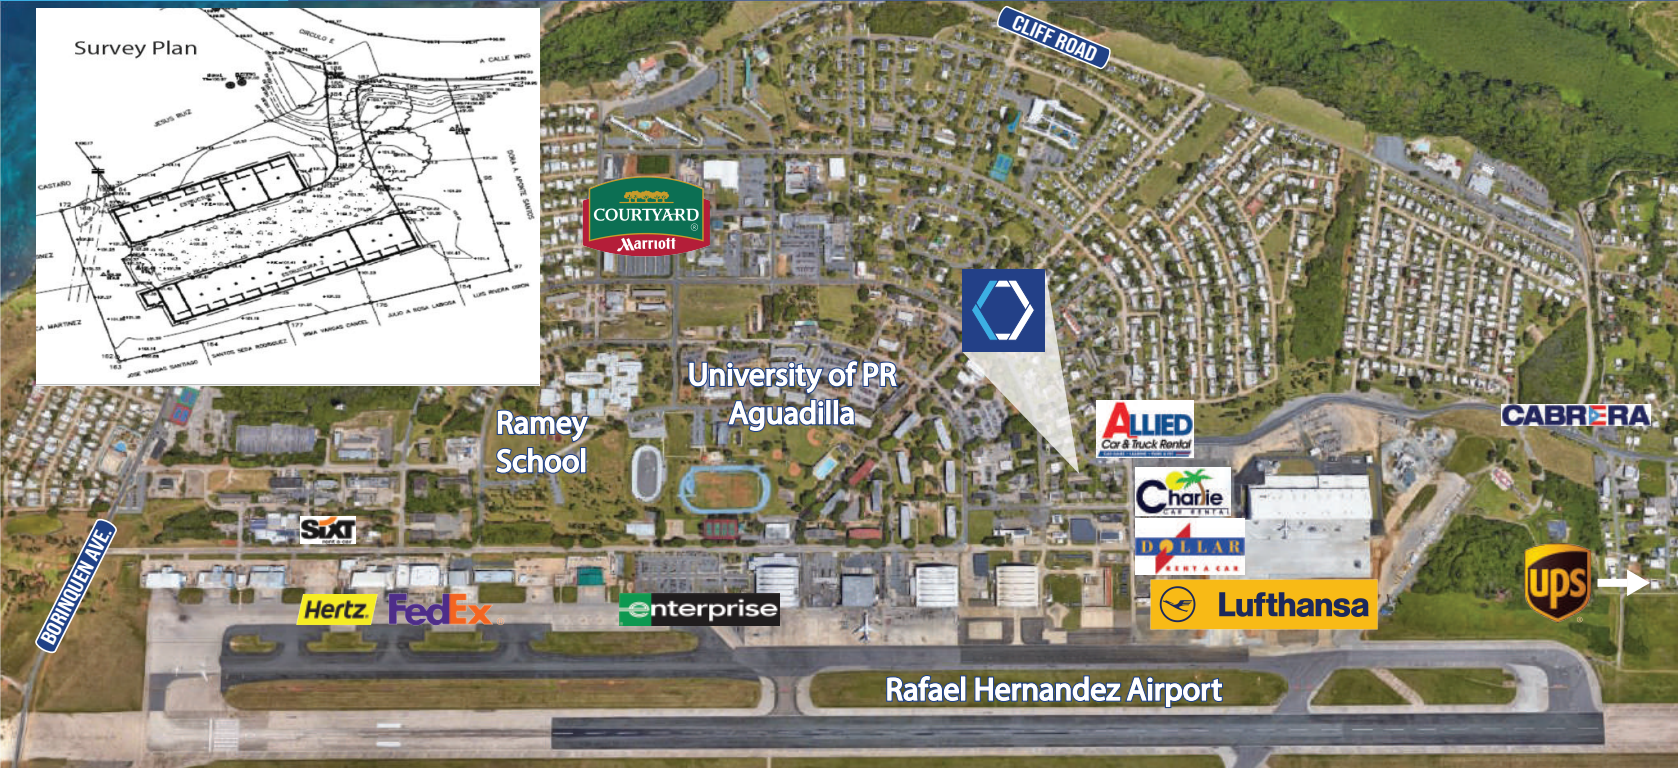


As-Built

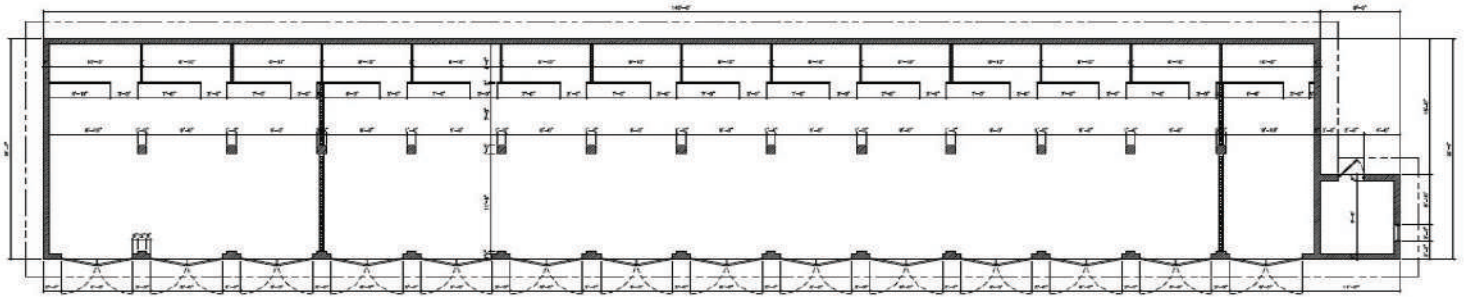

PLANTA DE DISTRIBUCION ARQUITECTONICA EXISTENTE EDIFICIO "A"

Building A: 3,692 square feet

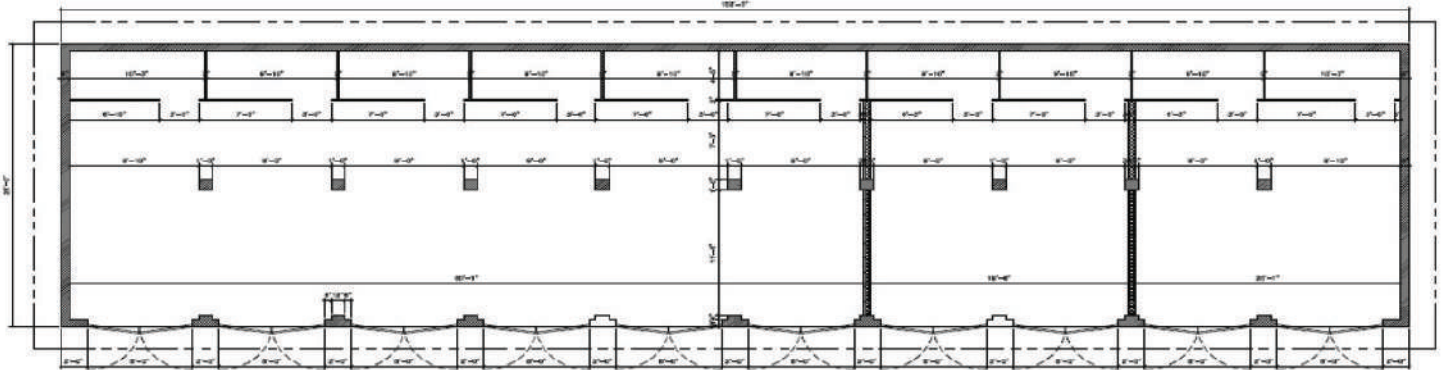

PLANTA DE DISTRIBUCION ARQUITECTONICA EXISTENTE EDIFICIO "B"

Building B: 2,652 square feet

American International Plaza
250 Muñoz Rivera Avenue Suite 350
Hato Rey, Puerto Rico 00918
www.christiansencommercial.com
787-778-7000



CAMERA SCAN FOR MORE DETAILS