


16409 NORTHCROSS

NOTE: old version-see as-built version for current interior wall configurations.

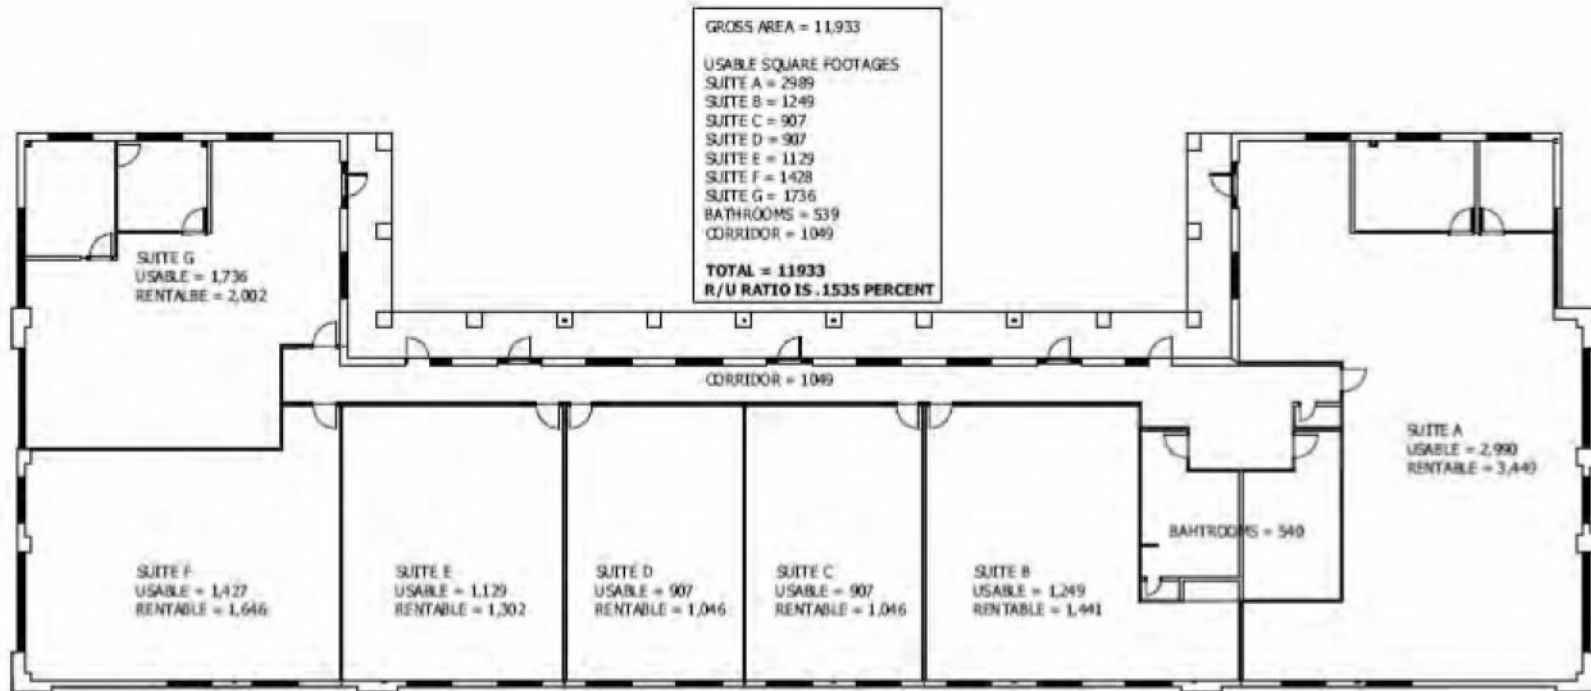

16409 NORTHCROSS

AS-BUILT - JANUARY 2021

ALL DIMENSION APPROXIMATE

NOT TO SCALE

