


FLOOR PLAN ISLA VERDE PARKING
SCALE: 1/8" = 1'-0"

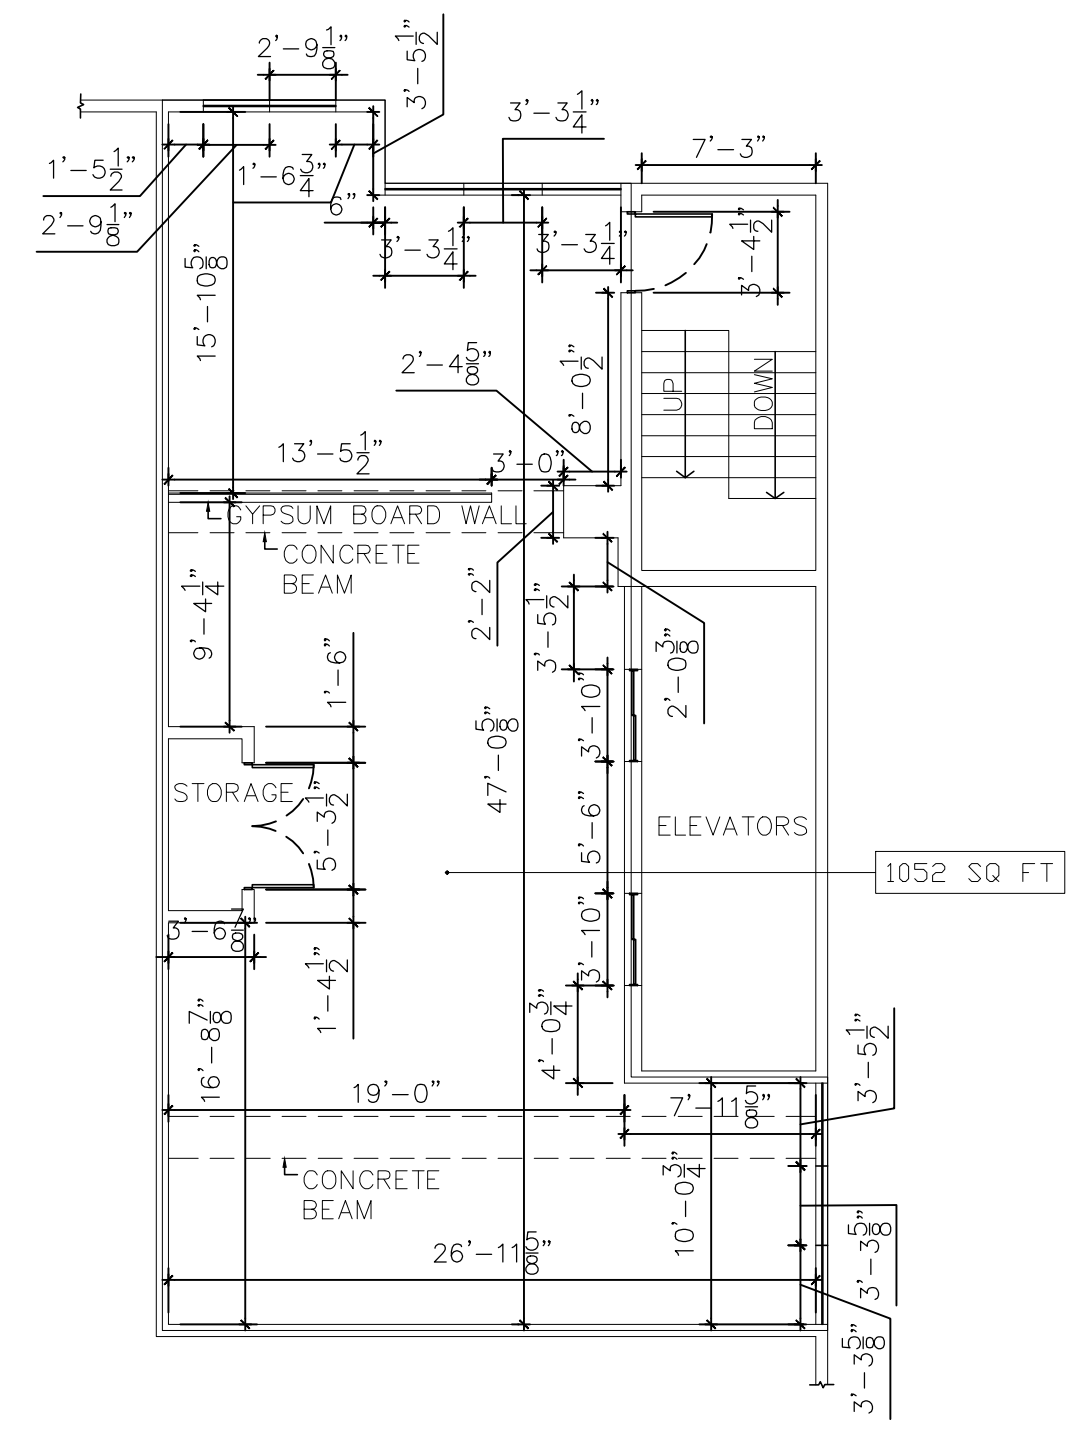

MEZZANIE FLOOR PLAN
SCALE: 1/8" = 1'-0"

REVISIONS	
SIMB.	DESCRIPTION

JOSE A. MELENDEZ MELENDEZ
U.S. 1001278

J.A.M.M. SURVEYING
JOSE A. MELENDEZ MELENDEZ
SURVEYING CONSULTANTS
CALLE GRONOS, A-27 VILLAS DE BUENA VISTA, BAYAMON, P.R.
EMAIL: jammsurvey@gmail.com
CELULAR (787) 644-4481

PLANIMETRIC AS-BUILT PLAN
OF ISLA VERDE PARKING
LOCATED AT ISLA VERDE AVENUE
AND DIAZ WAY NUMBER 6063
CAROLINA, PUERTO RICO

DRAWING TITLE:
PLANIMETRIC AS-BUILT PLAN

SCALE: 1/8" = 1'-0"	
FIELD WORK: JAMM	DRAWING NO. IVP
COMPUTED BY: JAMM	SHEET NO. 1 OF 1
REVISED BY: J.A.M.M.	
DATE: MARCH. 10, 2021	SHEETS