


CHARLES FIEDLER ENTERPRISES, INC.
ARCHITECTS

FIEDLER ARCHITECTS
ARCHITECTURE • INTERIOR DESIGN • PROJECT MANAGEMENT

NO PART OF THIS DOCUMENT IS TO BE REPRODUCED OR TRANSMITTED IN ANY FORM OR BY ANY MEANS, ELECTRONIC OR MECHANICAL, WITHOUT PERMISSION IN WRITING FROM CHARLES FIEDLER ENTERPRISES, INC.

Expansion of
Plant for FERRERO, Inc.
Puerto Rico

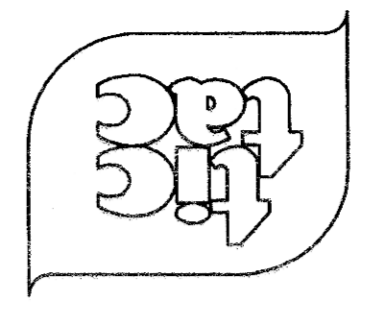


Revisions	Num	Date
	0	
	1	
	2	
	3	
	4	
	5	
	6	
	7	
	8	
	9	
	10	

Project No. 0517983
Start Date: -
Project in Charge: -
Design: -
Checked by: -
Drawn by: -

ISSUING TITLE
"AS BUILT" SECOND FLOOR PLAN
SCALE: 3/32" = 1'-0"

Page: **A8-2**

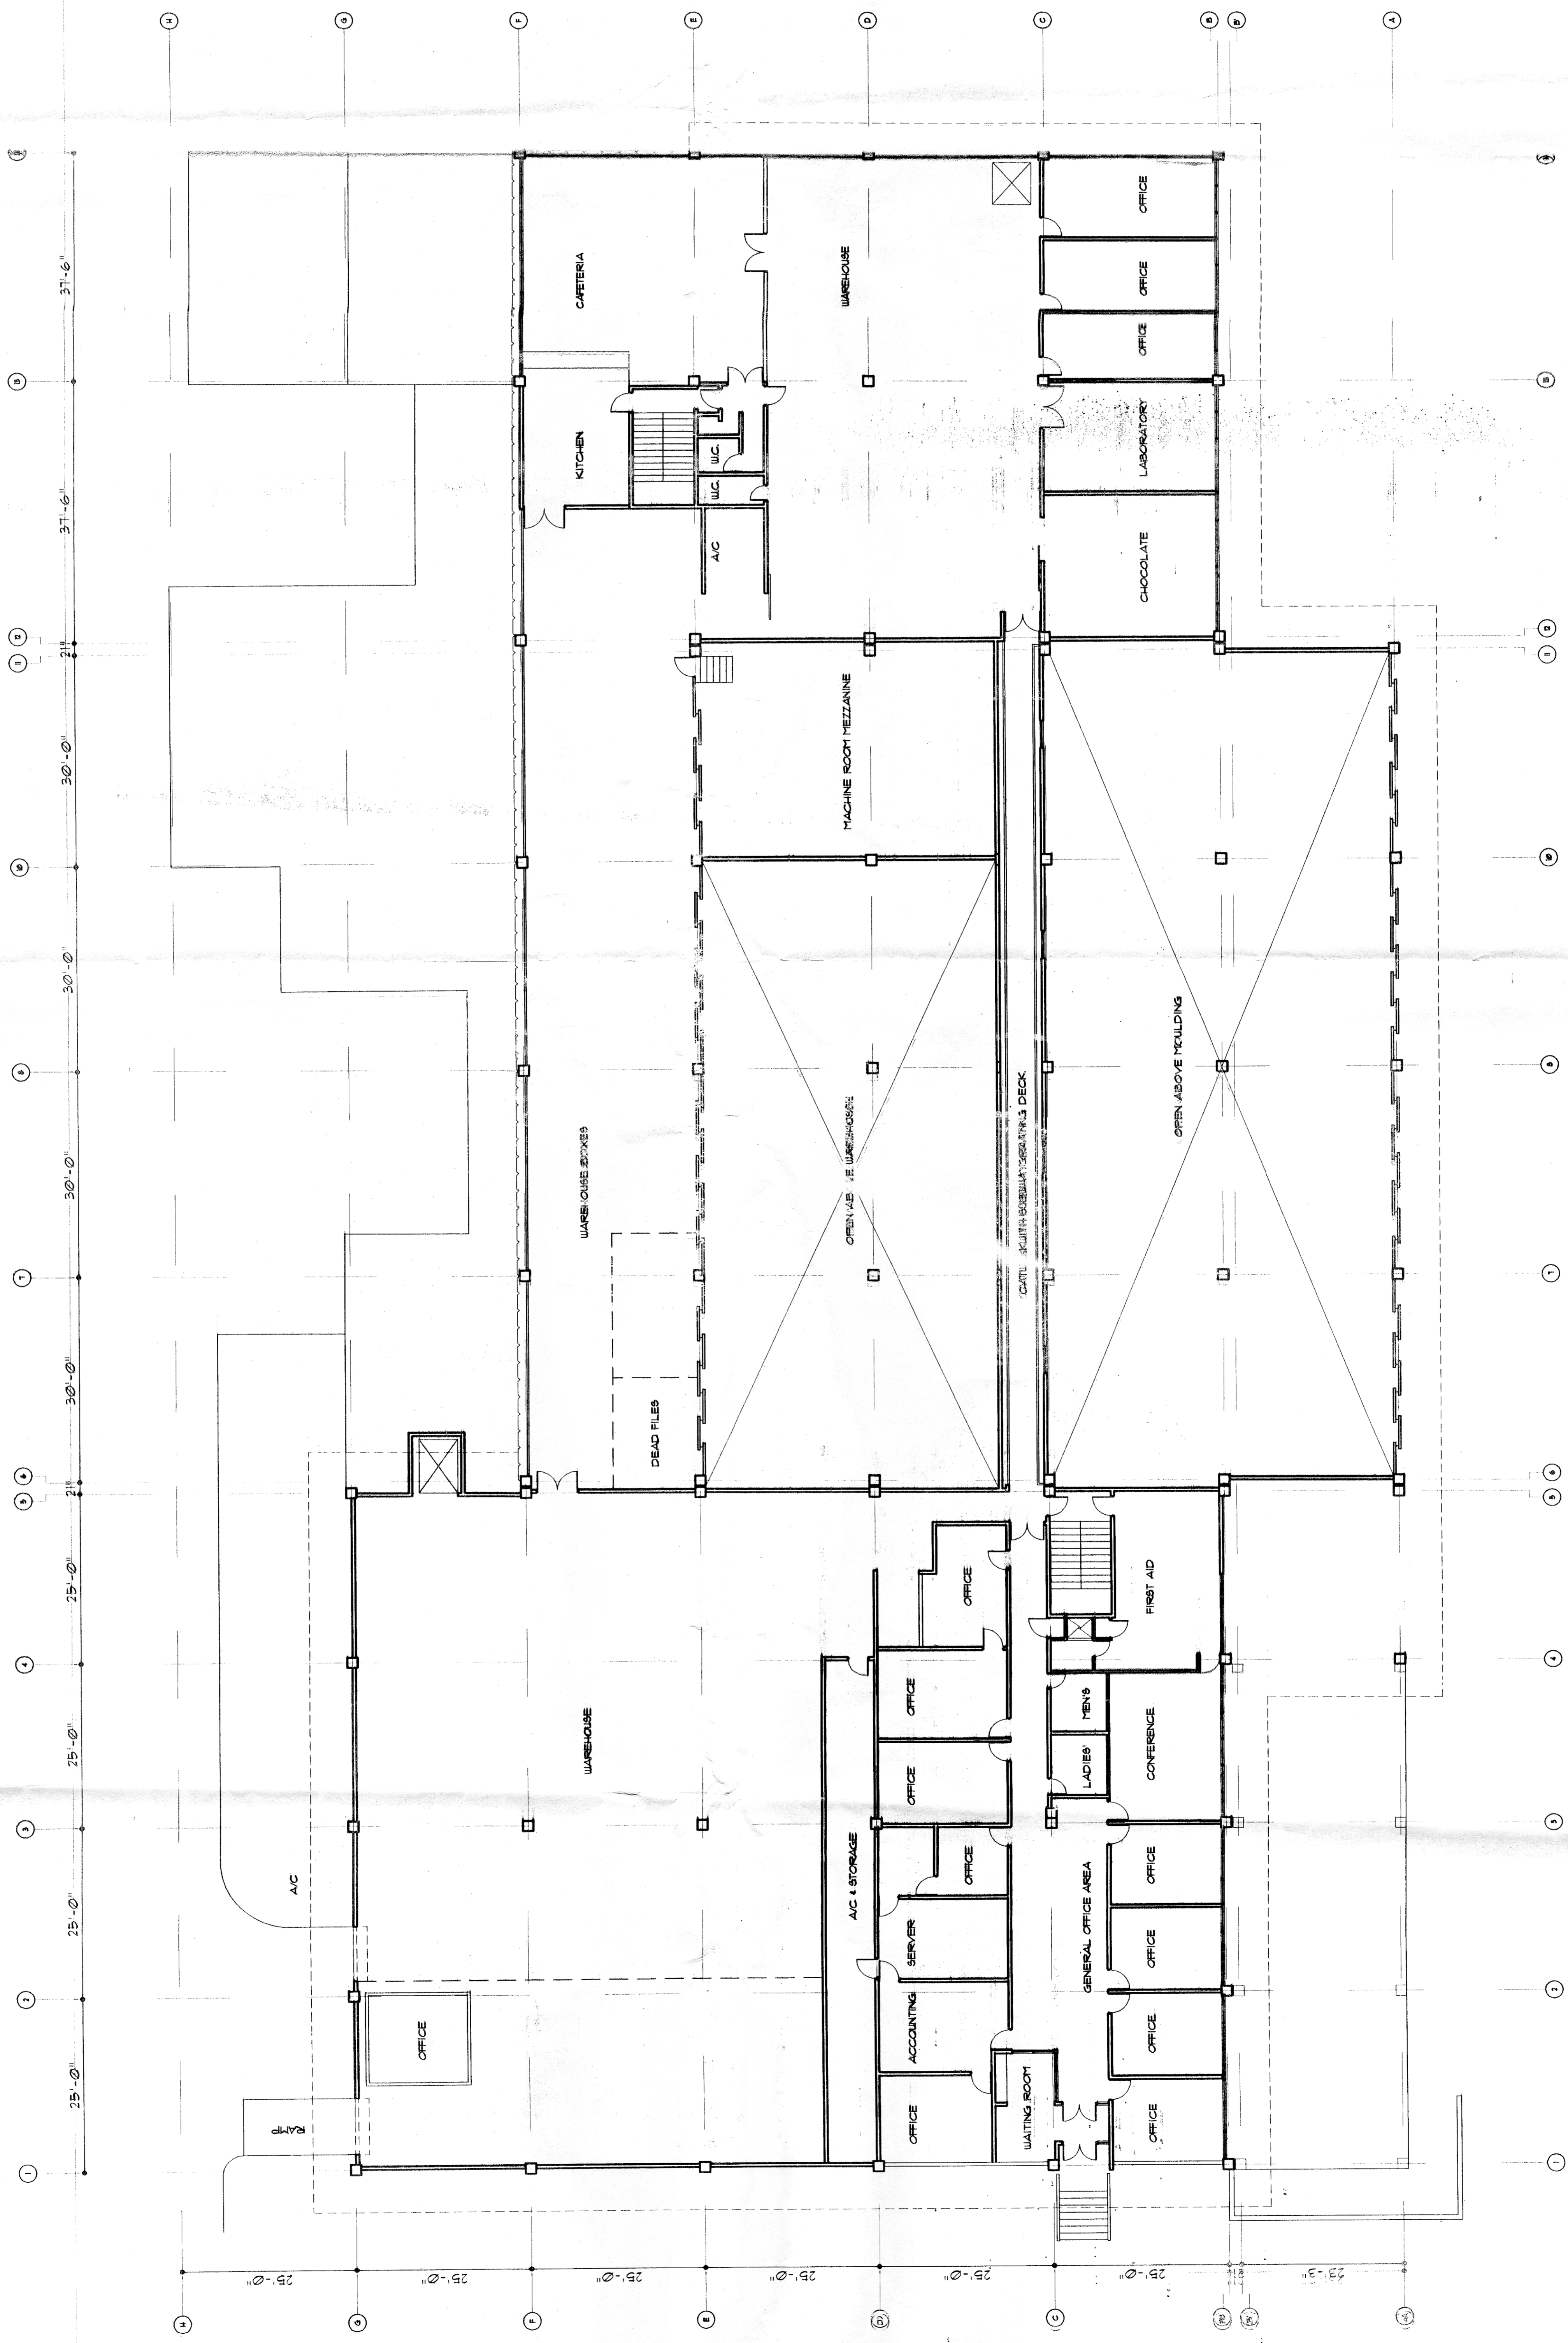

"AS BUILT" SECOND FLOOR PLAN

