


SCALE:

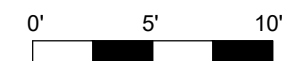

ORLANDO
407.971.8688

TAMPA
727.548.9595

www.measureDYNAMICS.COM

PREPARED FOR:

SCHUCHMANN STRUCTURAL
ASSOCIATES, LLC.

7560 RED BUG LAKE ROAD
SUITE 2020
OVIDO, FLORIDA 32765

PROJECT NAME:

OFFICE BUILDING

1486 SWANSON DRIVE
OVIDO, FLORIDA 32765

PROJECT NUMBER:

22-0104

DRAWN BY:

BJM

CHECKED BY:

LAC

DATE:

JANUARY 2022

SCALE:

1/8" = 1'-0"

SHEET TITLE:

FLOOR PLAN

SHEET NUMBER:

A-1