



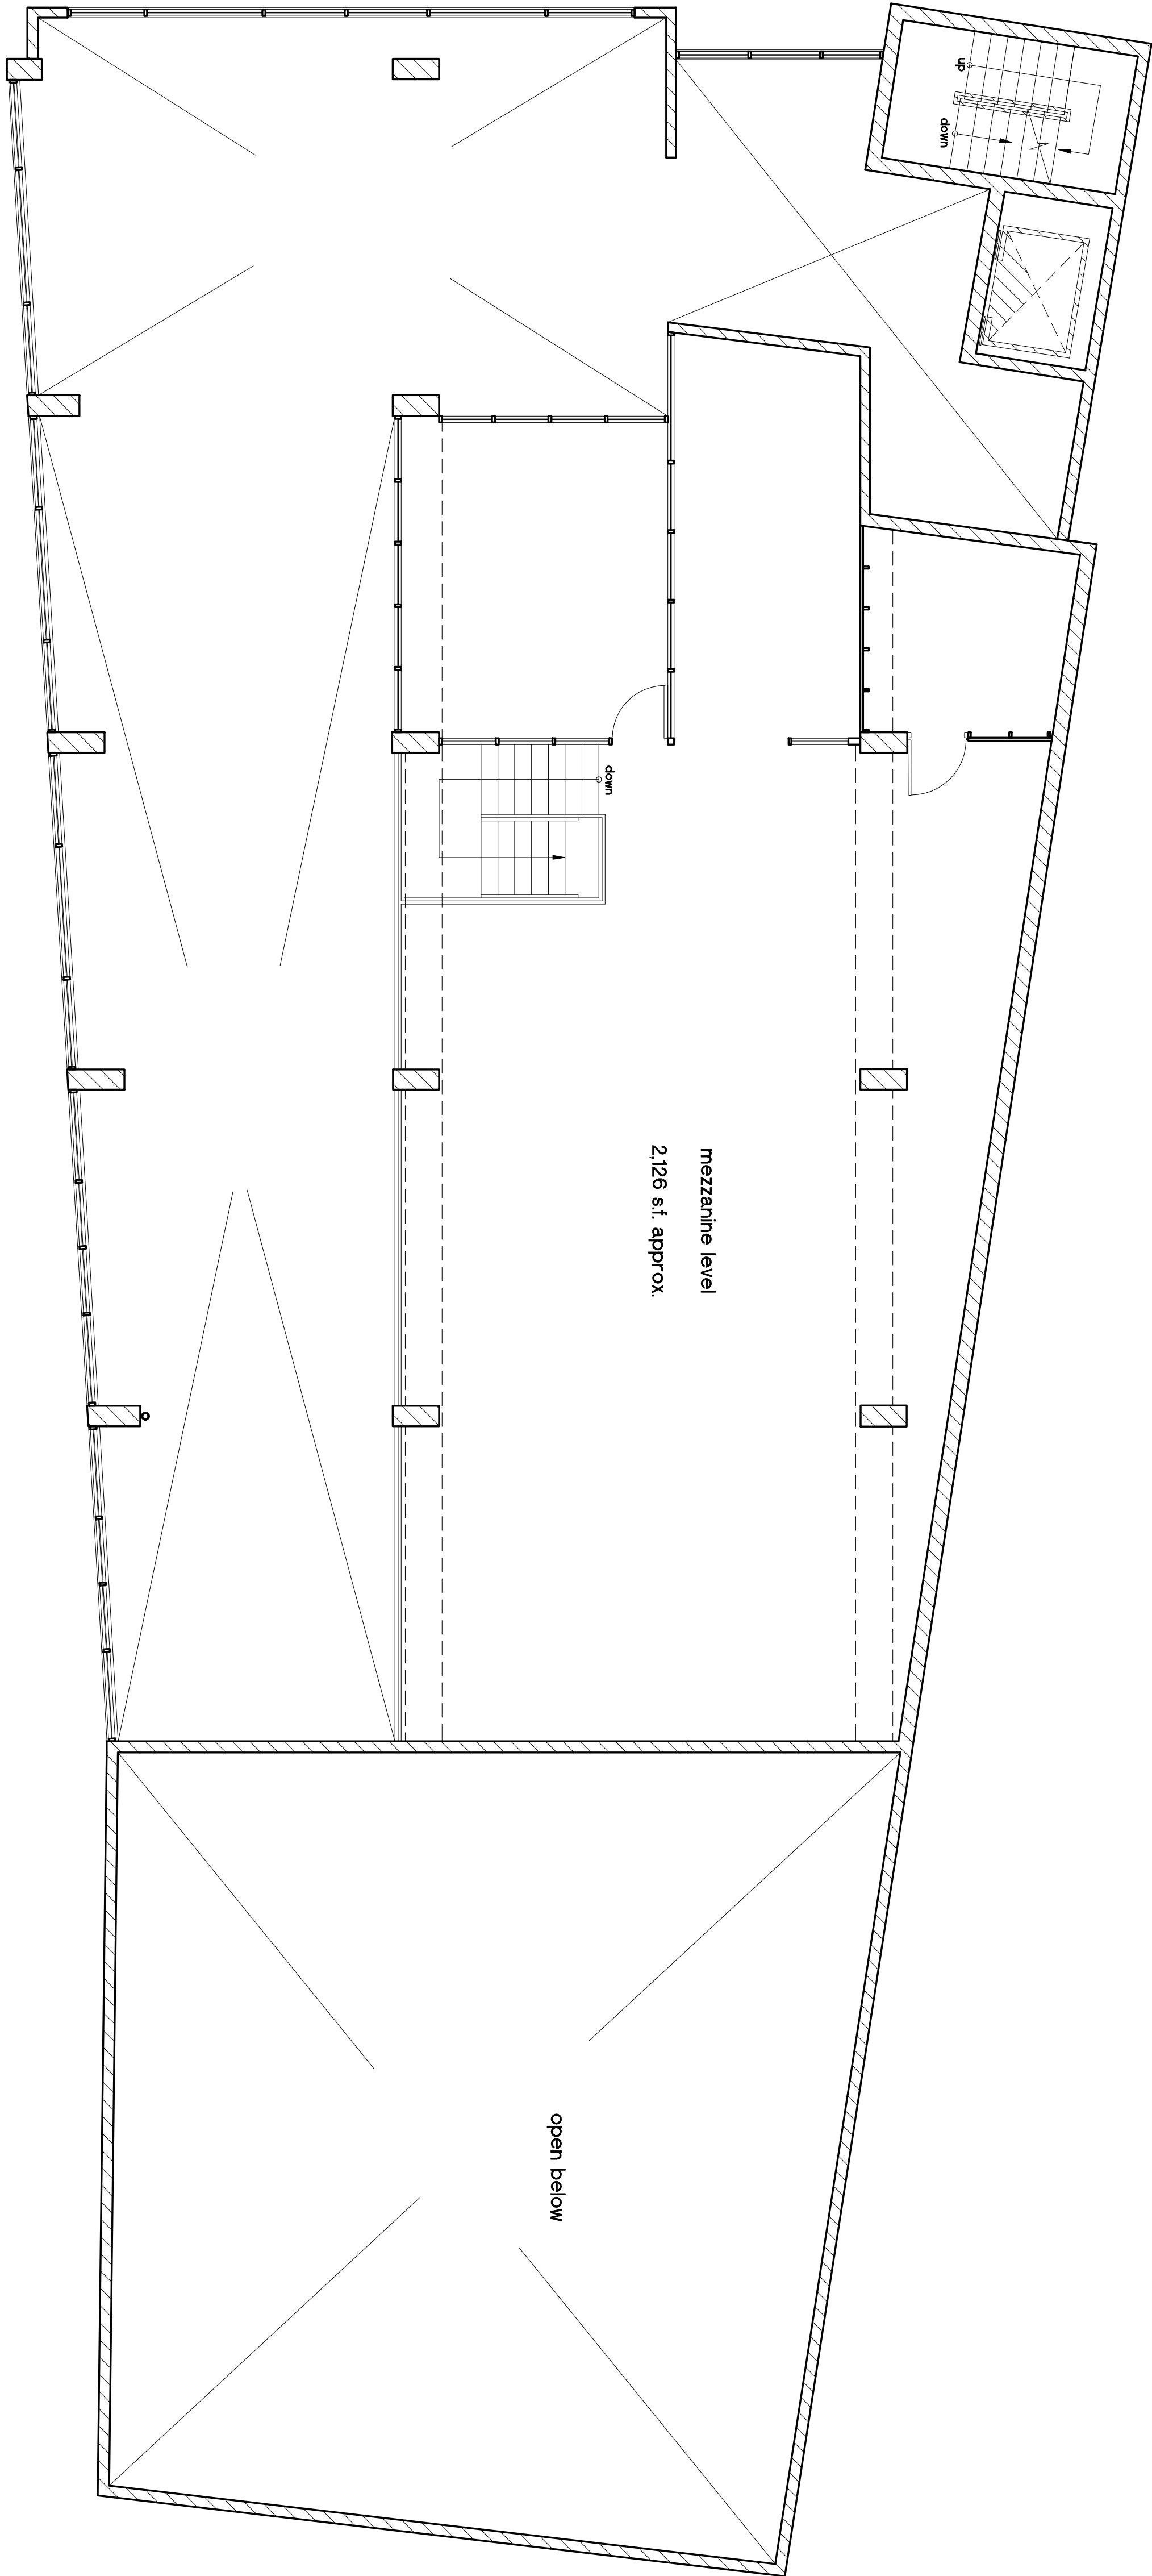

mezzanine level "as built"

SCALE 1/4" = 1'-0"

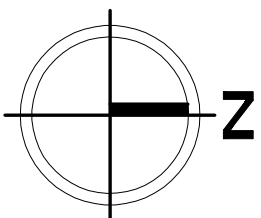

- LEGEND:
- EXISTING STRUCTURE WALLS
 - PROPOSED CONCRETE WALLS
 - PROPOSED BLOCK WALLS

THE GENERAL CONTRACTOR SHALL VERIFY ALL DIMENSIONS, LEVELS AND CONDITIONS AT THE SITE PRIOR TO THE COMMENCEMENT OF WORK. ANY DISCREPANCIES, ERRORS OR OMISSIONS ON THE PLANS SHALL BE NOTIFIED TO THE ARCHITECT BEFORE COMMENCEMENT OF ANY WORK. NO CHANGES OR MODIFICATIONS SHALL BE MADE WITHOUT THE WRITTEN CONSENT OF THE ARCHITECT. THE GENERAL CONTRACTOR SHALL BE SOLELY RESPONSIBLE FOR THE ACCURACY OF THE PLANS. IN ANY OTHER WORKS OR PLANS, EXCEPT FOR THE PURPOSES OF THIS DESIGN INTENT, THE GENERAL CONTRACTOR SHALL BE RESPONSIBLE FOR ANY DISCREPANCIES, ERRORS OR OMISSIONS. THE GENERAL CONTRACTOR SHALL BE RESPONSIBLE FOR THE ACCURACY OF THE PLANS. IN ANY OTHER WORKS OR PLANS, EXCEPT FOR THE PURPOSES OF THIS DESIGN INTENT, THE GENERAL CONTRACTOR SHALL BE RESPONSIBLE FOR ANY DISCREPANCIES, ERRORS OR OMISSIONS. THE GENERAL CONTRACTOR SHALL BE RESPONSIBLE FOR THE ACCURACY OF THE PLANS. IN ANY OTHER WORKS OR PLANS, EXCEPT FOR THE PURPOSES OF THIS DESIGN INTENT, THE GENERAL CONTRACTOR SHALL BE RESPONSIBLE FOR ANY DISCREPANCIES, ERRORS OR OMISSIONS.

SAN JORGE 373
SAN JUAN, P.R. 00936

SHEET TITLE: MEZZANINE LEVEL		
PLOT SCALE: 1/4"=1'-0"	DATE: august/2016	DESIGN BY: R.PEREZ

CONSULTANTS:
OWNER:
STRUCTURAL:
ELECTRICAL:
MECHANICAL:
LANDSCAPE:

REVISIONS	