


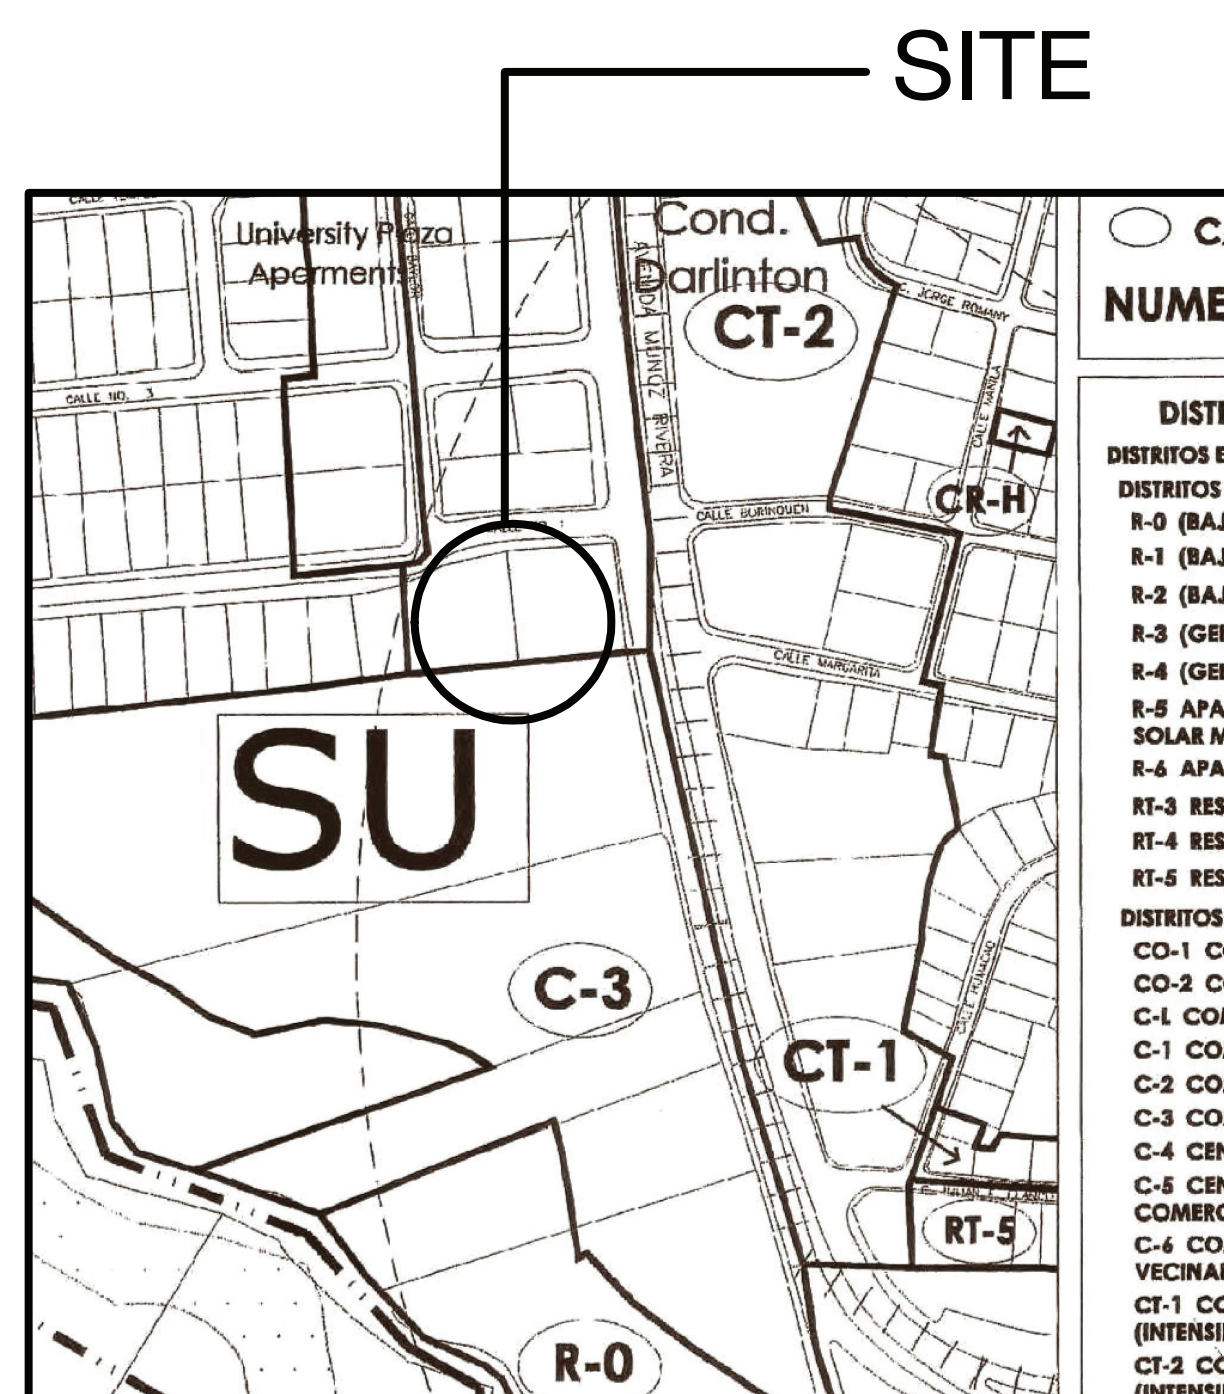

LAMBERT COORDINATES:
X = 18.463758°N
Y = 66.101746°W

[illegible]

FLOOD MAP
NOT TO SCALE

MAP NUMBER: 72000C0370J
MAP REVISED: NOVEMBER 18, 2009

INDEX	
TITLE	DESCRIPTION
T-100	TITLE SHEET
ASB-101	EXISTING GROUND FLOOR PLAN
ASB-102	EXISTING SECOND FLOOR PLAN
ASB-103	EXISTING THIRD FLOOR PLAN
ASB-104	EXISTING FOURTH FLOOR PLAN
ASB-105	EXISTING FIFTH FLOOR PLAN
ASB-106	EXISTING SIXTH FLOOR PLAN
ASB-107	EXISTING SEVENTH FLOOR PLAN
ASB-108	EXISTING EIGHT FLOOR PLAN

1058 MUÑOZ RIVERA AVE.

1058 MUÑOZ RIVERA AVENUE, SAN JUAN PR

[illegible]

ANY DISCREPANCIES, ERRORS OR OMISSIONS ON THE PLANS SHALL BE REFERRED TO THE ARCHITECT BEFORE COMMENCEMENT OF ANY WORK. THE ARCHITECT SHALL BE RESPONSIBLE FOR THE ACCURACY OF THE INFORMATION AND DATA PROVIDED TO HIM BY THE CLIENT. THE ARCHITECT SHALL BE RESPONSIBLE FOR THE ACCURACY OF THE INFORMATION AND DATA PROVIDED TO HIM BY THE CLIENT. THE ARCHITECT SHALL BE RESPONSIBLE FOR THE ACCURACY OF THE INFORMATION AND DATA PROVIDED TO HIM BY THE CLIENT.

PHASE
1058
MUÑOZ RIVERA AVE.
1058 MUÑOZ RIVERA AVE.
SAN JUAN, P.R.

CONSULTANTS:

AVIL: ING.

STRUCT.: ING.

LECT.: ING.

TECH.: ING.

HANDS: ING.


TITLE PAGE	PLOT SCALE: $3/8"=1'-0"$ DATE: _____	DESIGN BY: _____ DB

DRAWING NO.:

T-100




DRAWING NO.:
ASB-100

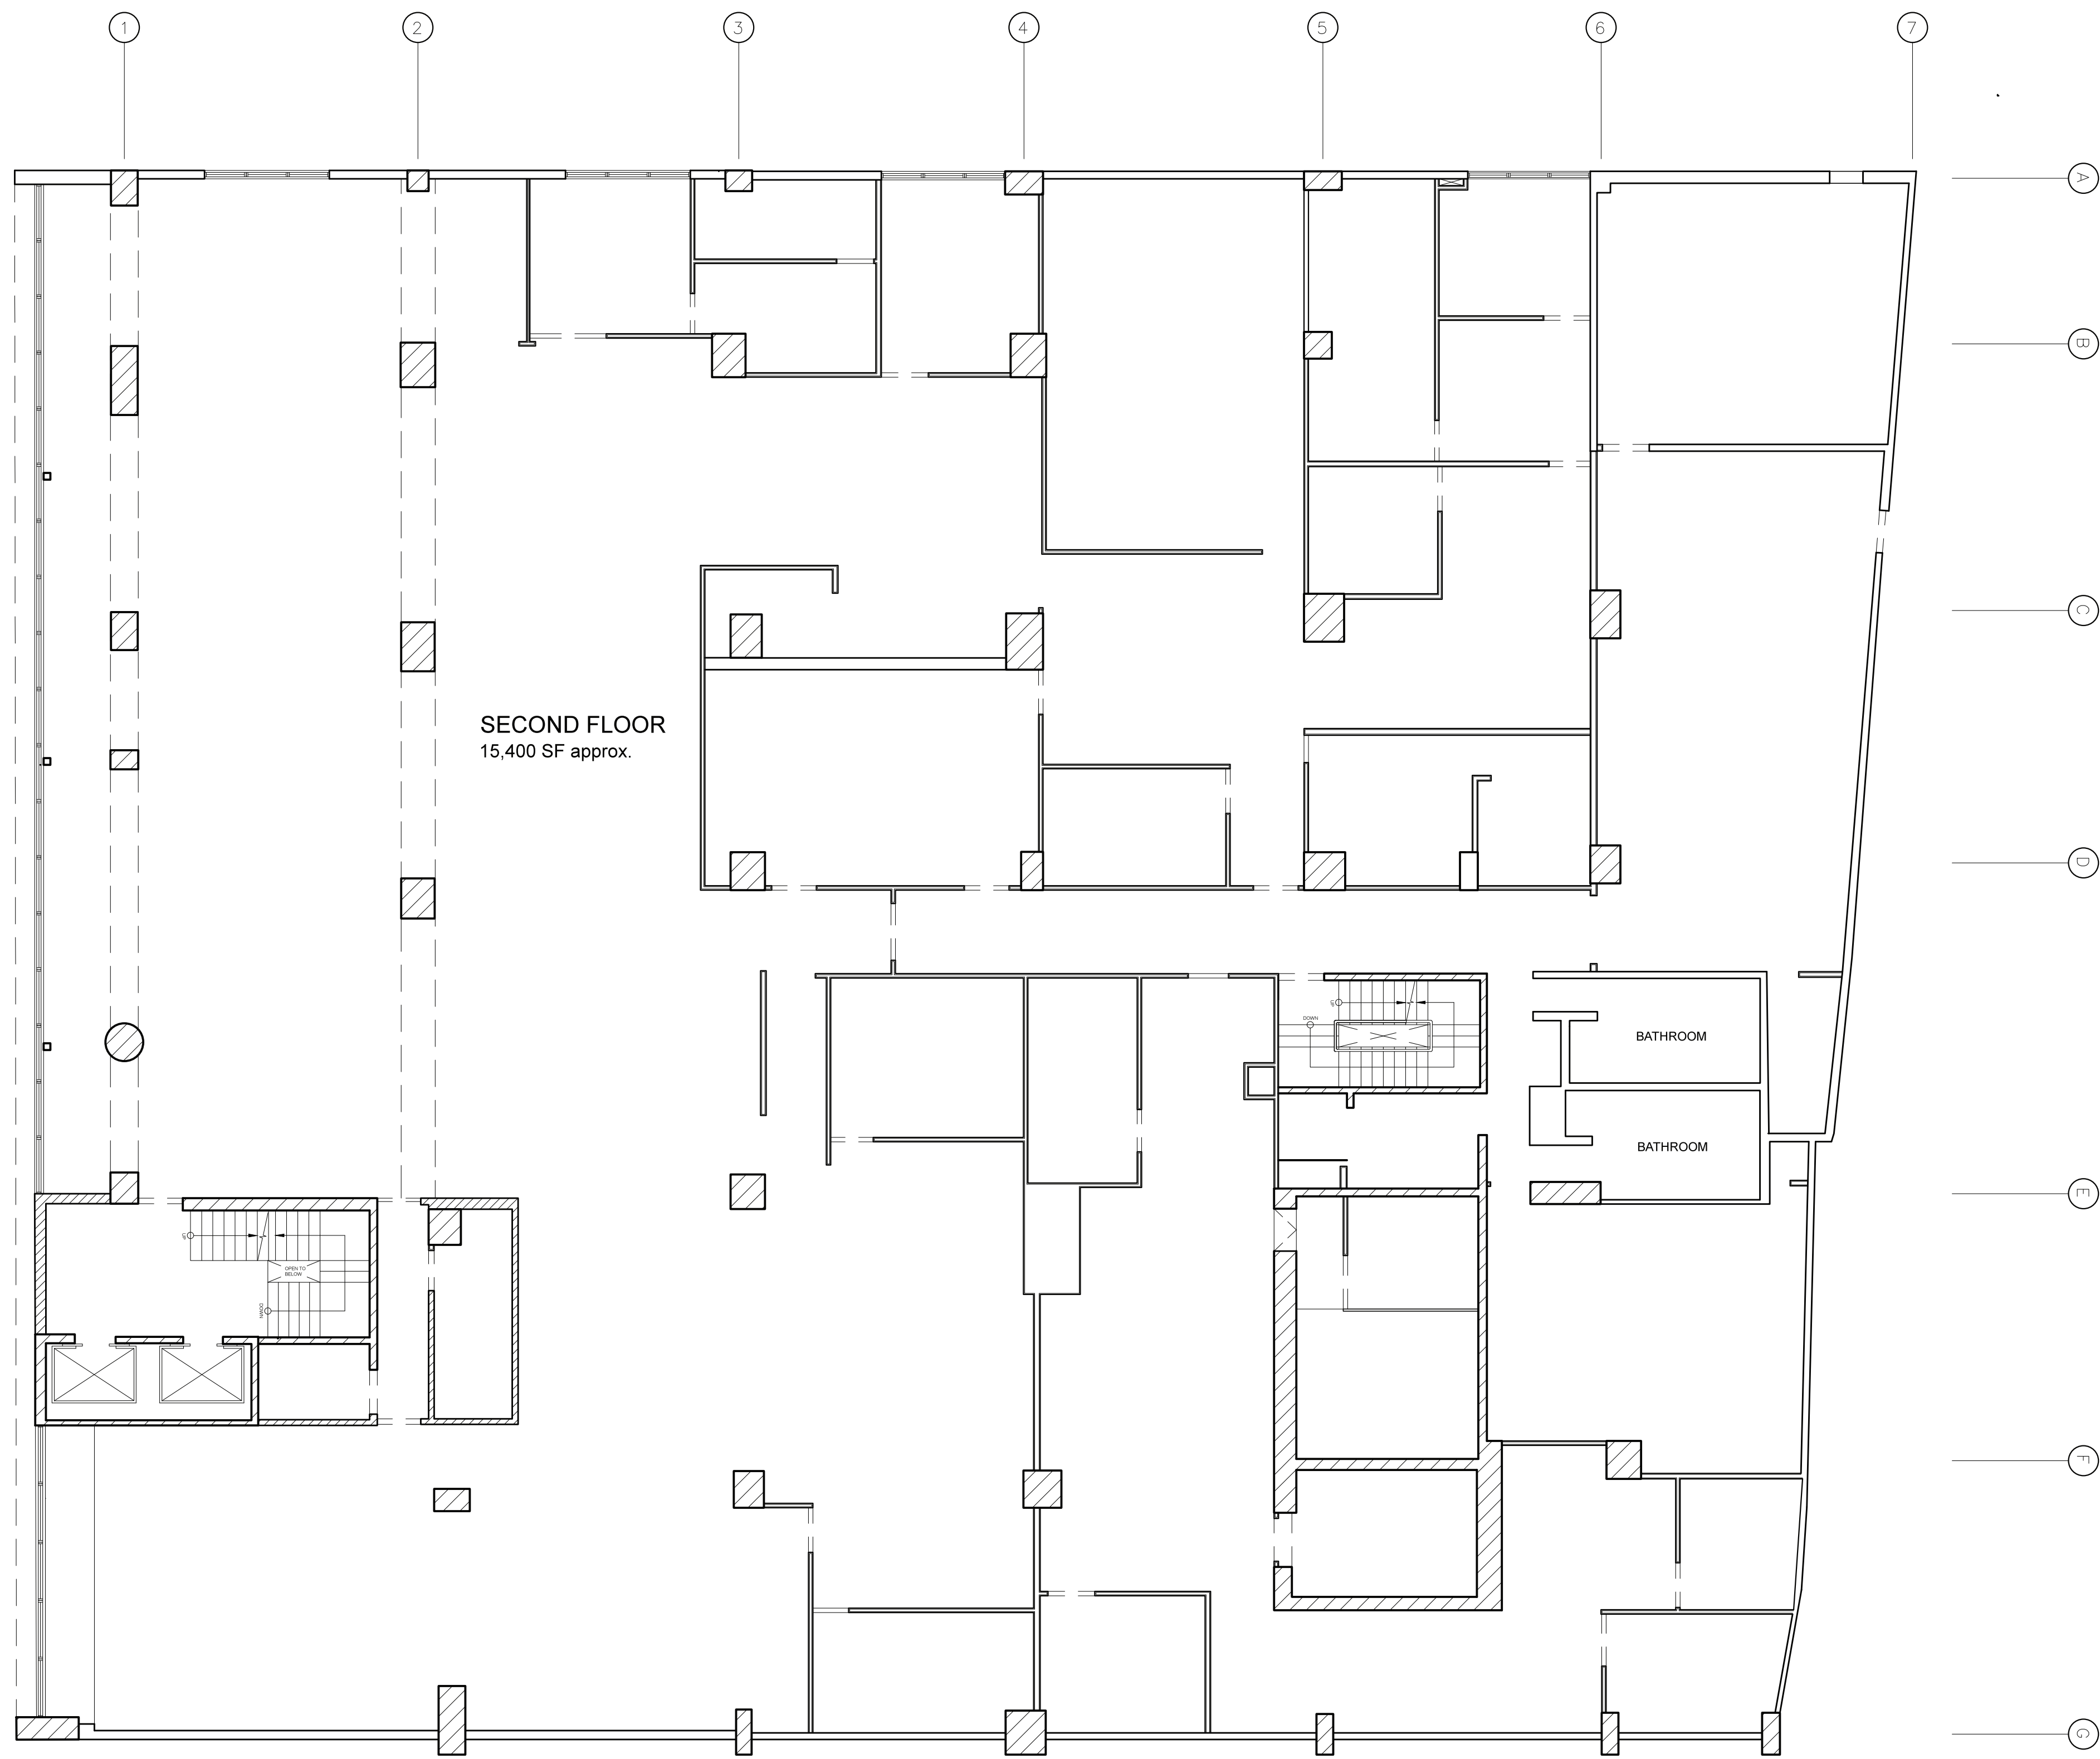

1058 Ave. MUÑOZ RIVERA | SECOND FLOOR
SCALE 1/8" = 1'-0"

DRAWING NO.: ASB-101	
SHEET TITLE: AS BUILT - SECOND FLOOR PLAN	
PLANT SCALE: 1/8" = 1'-0"	DATE: JUNE 2020
DESIGN BY: DB	DRAWING BY: DB
CONSULTANTS: CIVIL: ING. STRUCT.: ING. ELECT.: ING. MECH.: ING. LANDS.: ING.	
PHASE 1058 MUÑOZ RIVERA SAN JUAN, PR	
REVISIONS	

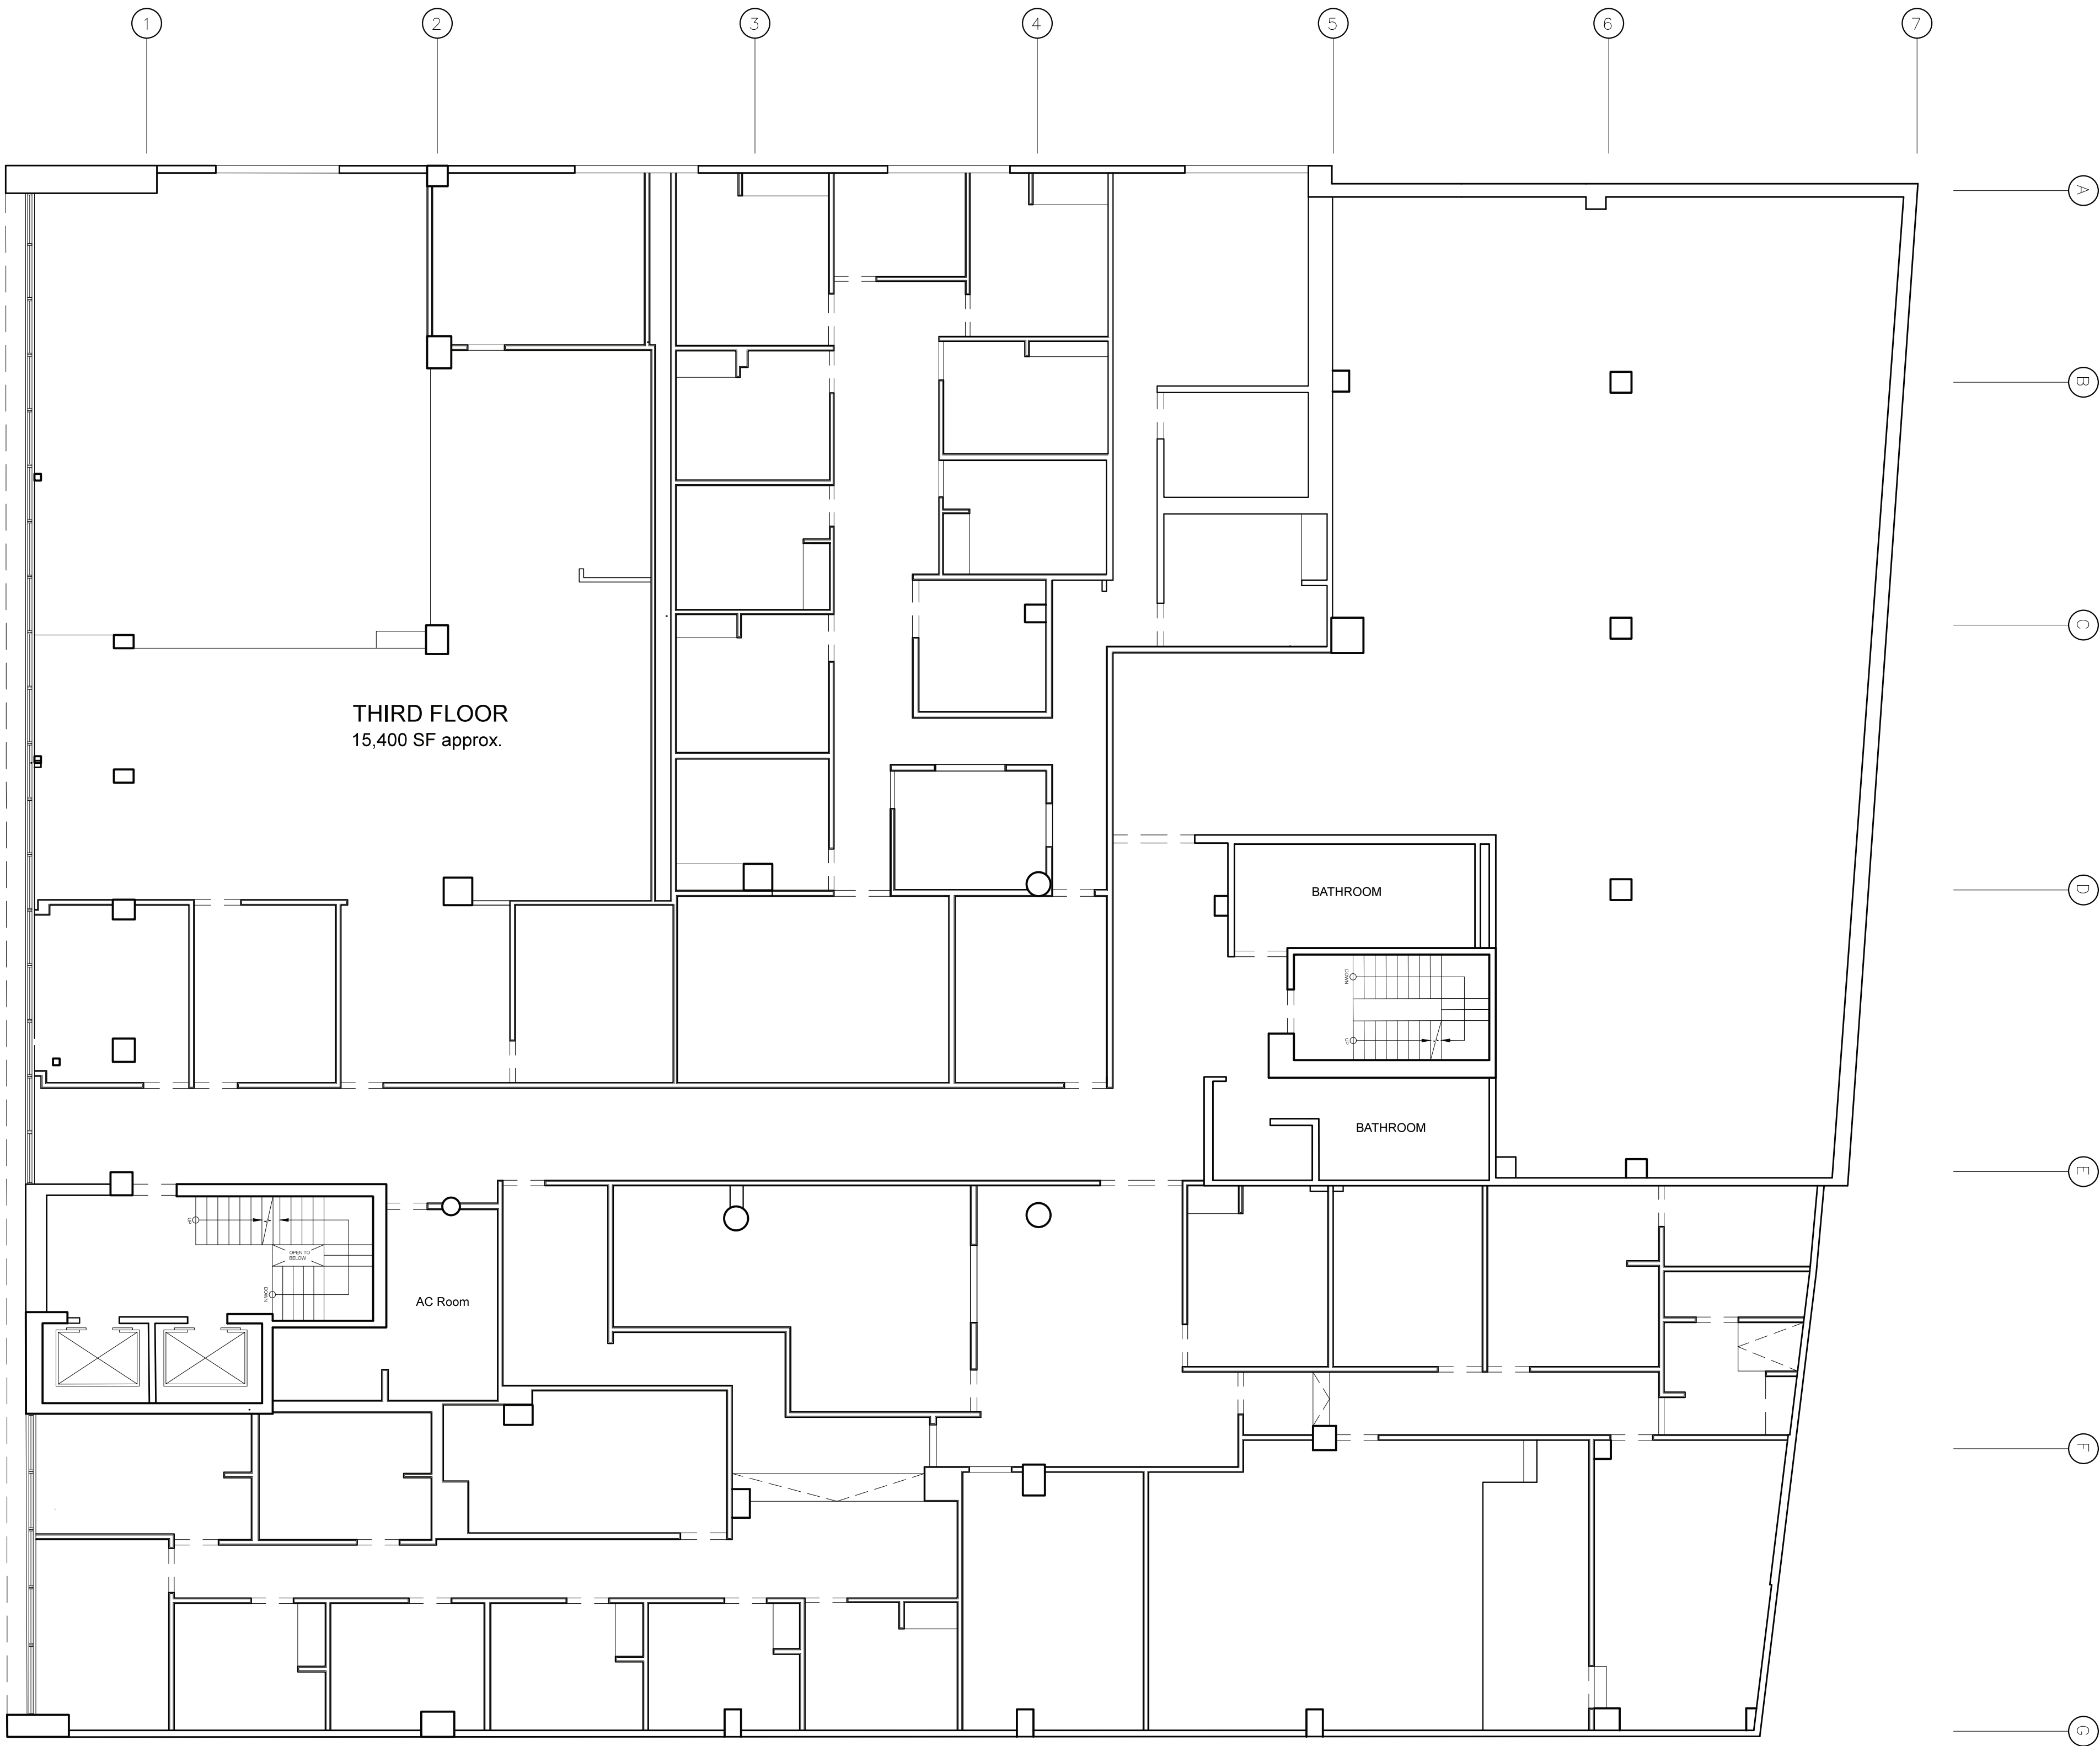

1058 Ave. MUÑOZ RIVERA | THIRD FLOOR


SCALE 1/8" = 1'-0"

DRAWING NO.: ASB-102	
SHEET TITLE: AS BUILT - THIRD FLOOR PLAN	
DATE: JUNE 2020	DESIGN BY: DB
DRAWING BY:	
CONSULTANTS: CIVIL: ING. STRUCT.: ING. ELECT.: ING. MECH.: ING. LANDS.: ING.	
PHASE 1058 MUÑOZ RIVERA 1058 MUÑOZ RIVERA SAN JUAN, PR	
REVISIONS	



DRAWING NO.:

ASB-103

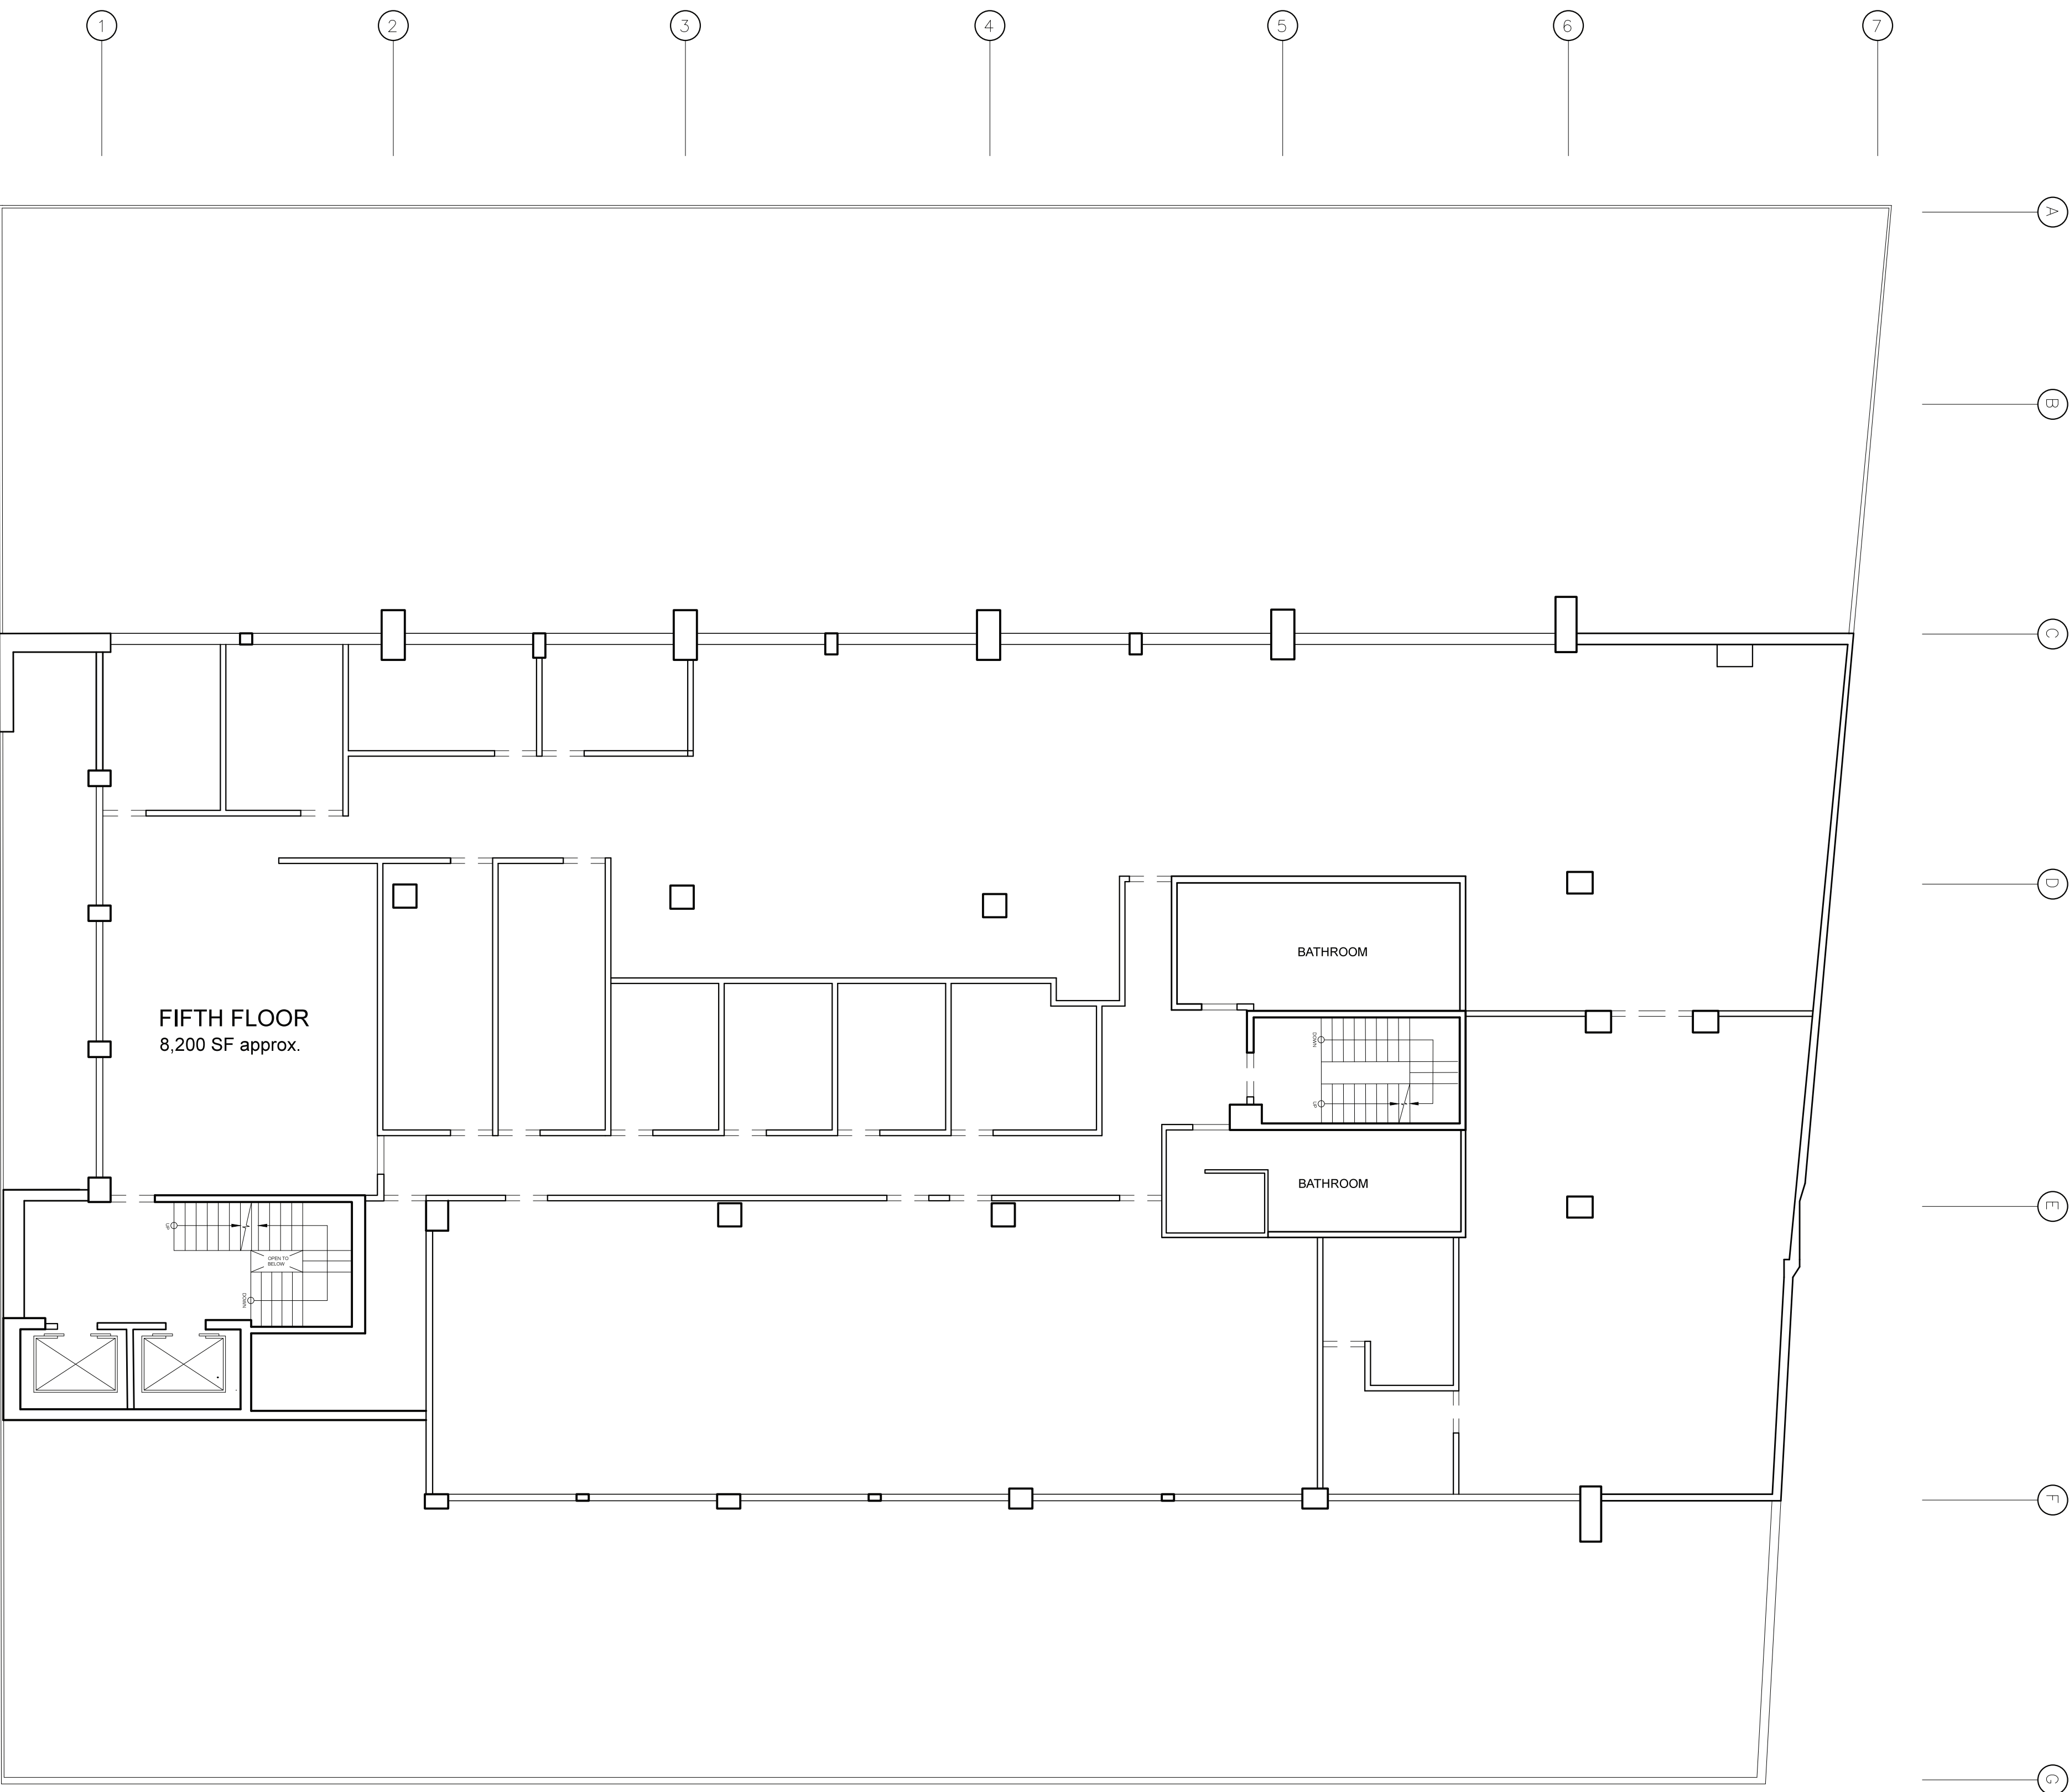

1058 Ave. MUÑOZ RIVERA | FIFTH FLOOR

SCALE 1/8" = 1'-0"

[illegible]

PHASE

1058 MUÑOZ RIVERA

1058 MUÑOZ RIVERA
SAN JUAN, PR

CONSULTANTS:

CIVIL:	ING.
STRUCT.:	ING.
ELECT.:	ING.
MECH.:	ING.
LANDS.:	ING.

AS BUILT – FIFTH FLOOR PLAN

BY:


DESIGN BY: B

DATE: MAY 2020

-0-


DRAWING NO.:

ASB-104

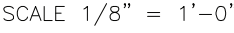

DRAWING NO.:

ASB-105

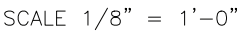

DRAWING NO.:

ASB-106



DRAWING NO.:

ASB-107