


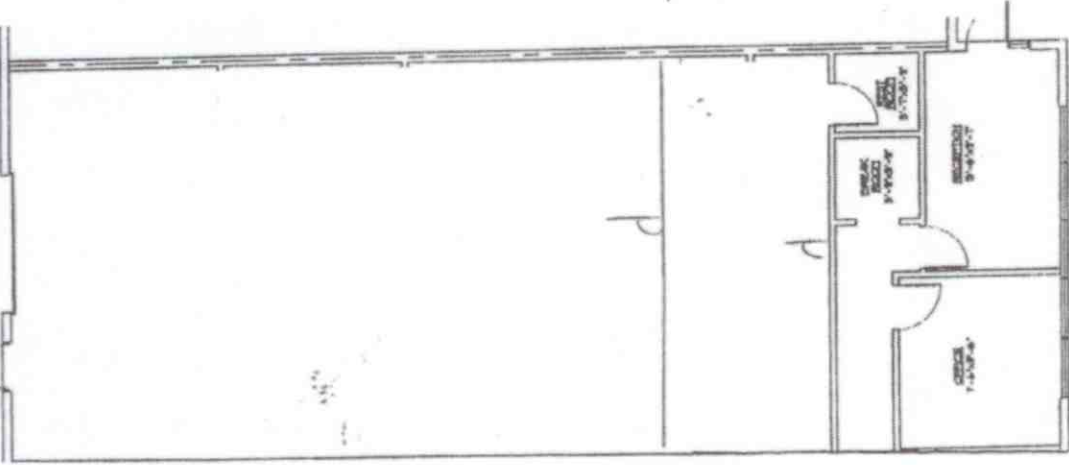

PARK 33
 331 BARTLETT BOULEVARD
 CHLANDO, N. CAROLINA

BUILDING III

42 3313

2072 Ø



AS-BUILT FLOOR PLAN
 THIS IS NOT A SURVEY. ALL DIMENSIONS ARE
 NOMINAL AND SUBJECT TO FIELD VERIFICATION.