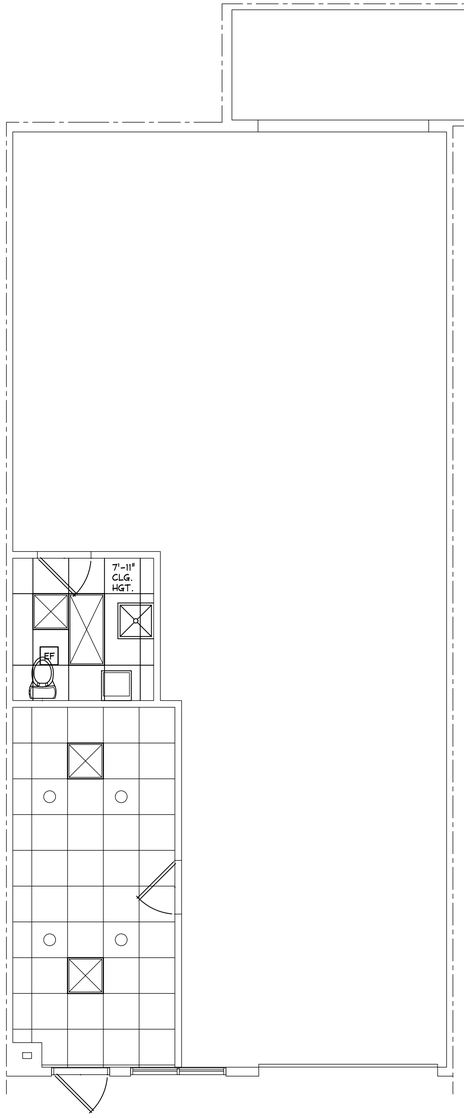

SUITE 9
REFLECTED CEILING PLAN

SCALE: 1/4" = 1'-0"

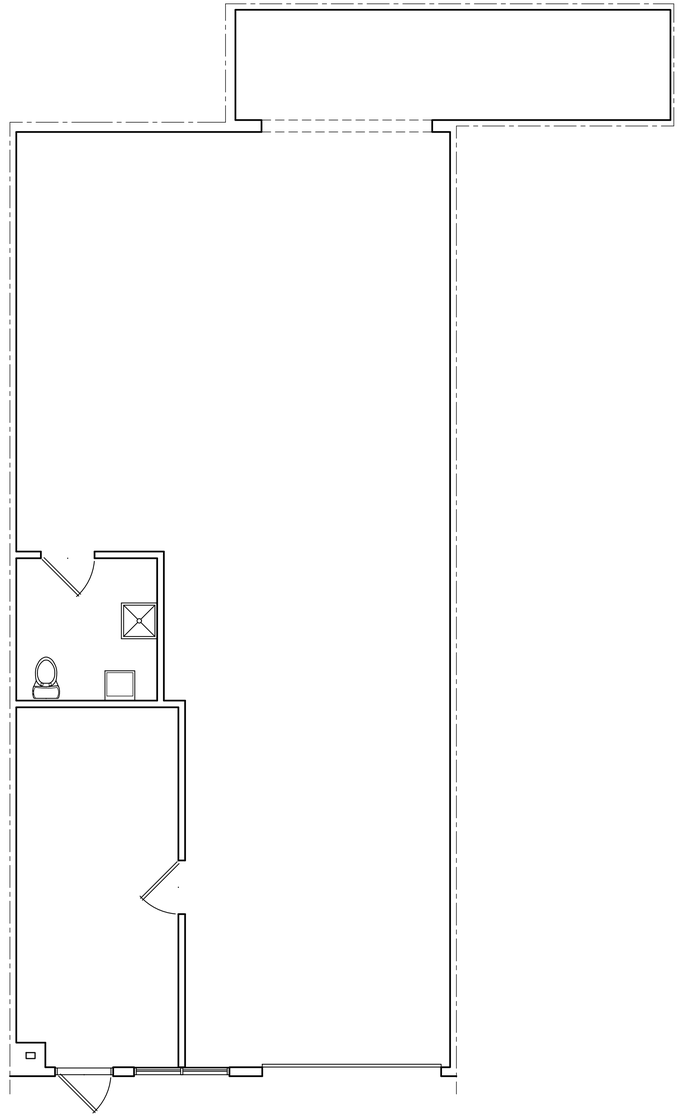

SUITE 9 PLAN

SCALE: 1/4" = 1'-0"

BUILDING AREA
SUITE 9 - 1,500 SQ. FT.

DATE	REV.NO.	DESCRIPTION
11/9/20	1	MOVE OFFICE FROM BACK LEFT TO FRONT LEFT

West & Associates
ARCHITECTS
4389 SHELBORNE DRIVE, DUNWOODY, GEORGIA 30338-6615 (770) 457-4495

SEAL

STATE OF GEORGIA
STEPHEN BLAINE WEST
CERTIFICATE NO. 9812
REGISTERED ARCHITECT

DRAWN | CHECKED | APPROVED

SHEET TITLE
SUITE 9 PLAN & REFLECTED CEILING PLAN

PROJECT NAME
AS-BUILT SURVEY
FOR 120 GLOSTER RD. - LAWRENCEVILLE, GA

REPRODUCTION RESTRICTION
This drawing is the property of the Architect and may not be copied or reproduced without the written permission of the Architect.

PROJECT NO.	DATE
2012110.00	*6 JUNE 2012*

SHEET NO.

A-9