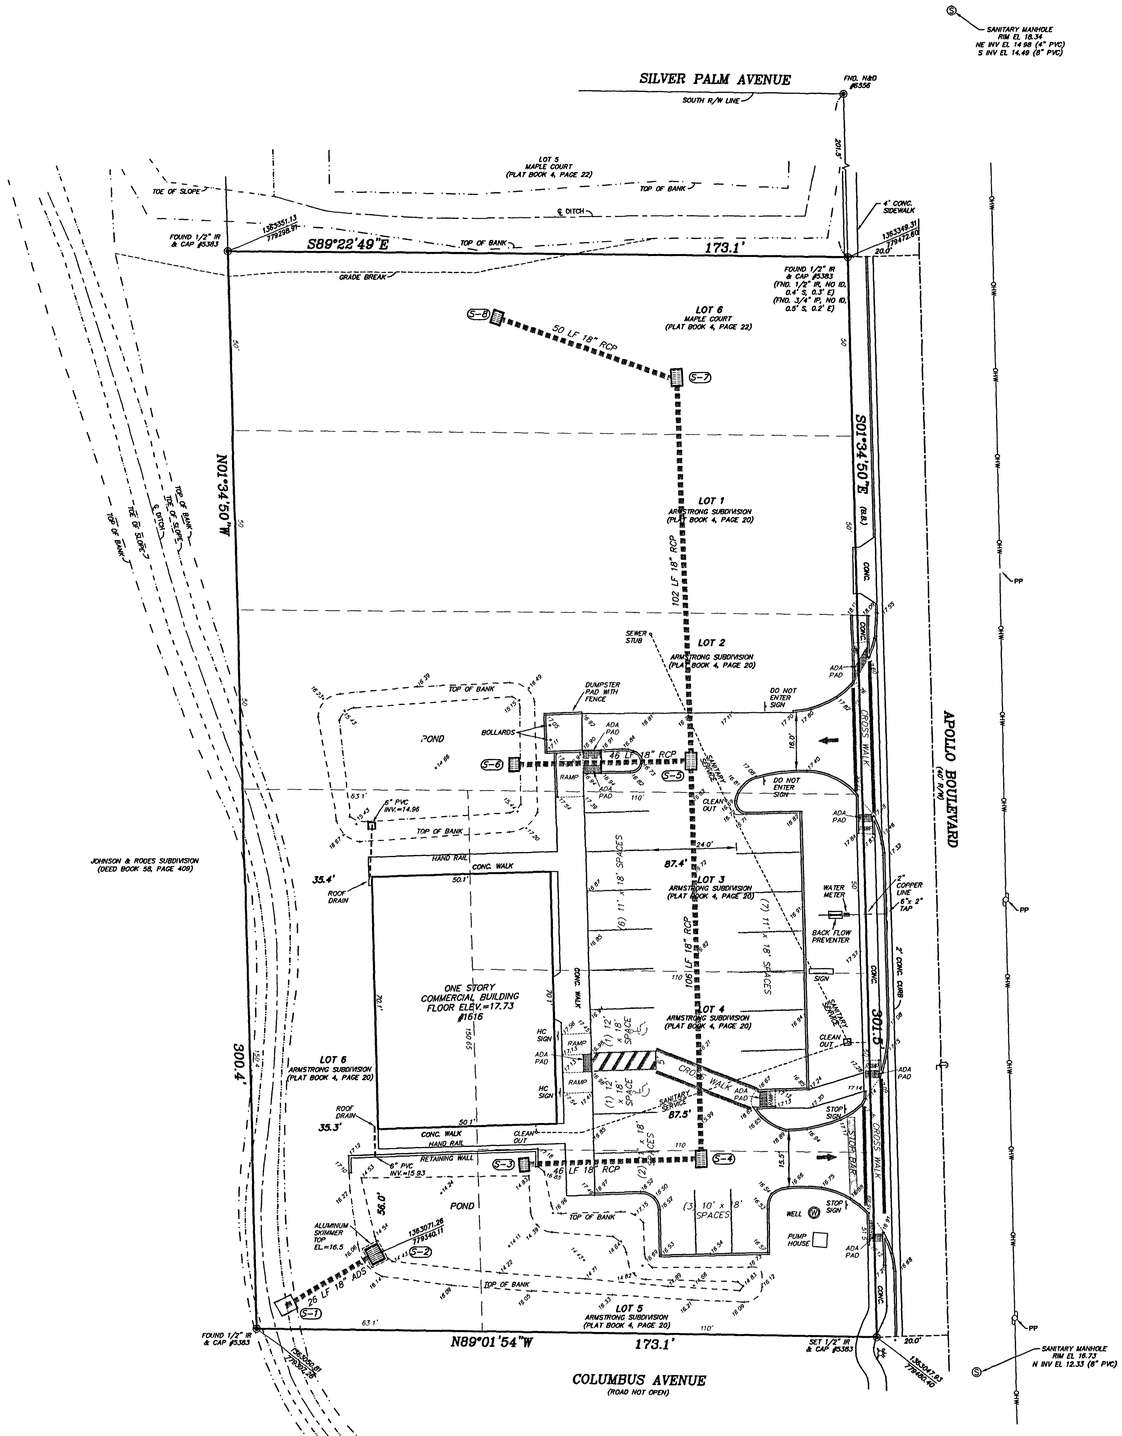

STRUCTURE S-1
W.INV.=9.31

STRUCTURE S-2
WEIR 2.95'x0.3'
RIM ELEV.=15.95
WEIR ELEV.=15.27
W.INV.=13.28

STRUCTURE S-3
RIM ELEV.=14.91
E.INV.=8.34
E.INV=12.74 (6" PVC)

STRUCTURE S-4
RIM ELEV.=15.90
N.INV.=9.15
W.INV=8.98

STRUCTURE S-5
RIM ELEV.=16.51
N.INV.=9.93
S.INV=9.93
W.INV=9.84

STRUCTURE S-6
RIM ELEV.=14.83
E.INV.=10.98

STRUCTURE S-7
RIM ELEV.=17.19
W.INV.=10.61
S.INV=10.44

STRUCTURE S-8
RIM ELEV.=14.67
E.INV.=11.13

NOTES:

1. CITY OF MELBOURNE: KUMAR
2. STATE PLANE COORDINATES SHOWN ARE BASED ON NAD 83 FLORIDA EAST
3. IMPORVEMENTS SHOWN ARE BASED UPON FIELD LOCATION OF ITEMS AND CONTRACTOR NOTES AND ARE A TRUE REPRESENTATION,

DESCRIPTION: LOTS 1-6, ARMSTRONG SUBDIVISION, ACCORDING TO THE PLAT THEREOF, AS RECORDED IN PLAT BOOK 4, PAGE 20, AND LOT 6, MAPLE COURT, ACCORDING TO THE PLAT THEREOF, AS RECORDED IN PLAT BOOK 4, PAGE 22, ALL OF THE PUBLIC RECORDS OF BREVARD COUNTY, FLORIDA.

AS-BUILT SURVEY

AAL LAND SURVEYING SERVICES, INC.

ACCORDING TO F.I.R.M. #12009C 0528 E, DATED APRIL 3, 1989, THIS PROPERTY IS LOCATED WITHIN FLOOD ZONE X.

AS-BUILT SURVEY

SCALE: 1" = 20'

NORTH

JOB # 27450

REVISION: ADD WELL 12/5/11

FIELD SURVEY DATE: 11/30/2011
SECTION 3, TOWNSHIP 28 S, RANGE 37 E

L.B. #6623

NOTES:

1. THIS SURVEY AND DRAWING HAVE BEEN PREPARED TO CONFORM WITH APPLICABLE MINIMUM TECHNICAL STANDARDS AS SET FORTH BY THE FLORIDA BOARD OF PROFESSIONAL LAND SURVEYORS IN CHAPTER 5J-17, FLORIDA ADMINISTRATIVE CODE, PURSUANT TO SECTION 472.027, FLORIDA STATUTES.
2. THIS SURVEY IS FOR THE SOLE BENEFIT OF THE PARTIES NAMED HEREON AND FOR THE SPECIFIC PURPOSE NOTED, AND SHOULD NOT BE RELIED UPON BY ANY OTHER ENTITY, AND IS NOT TRANSFERABLE UNDER ANY CIRCUMSTANCES.
3. THIS SURVEY IS NOT VALID WITHOUT THE SIGNATURE AND THE ORIGINAL RAISED SEAL OF THE FLORIDA LICENSED SURVEYOR, AND REPRODUCTION OF THIS DRAWING WITHOUT WRITTEN PERMISSION OF THE SURVEYOR IS HEREBY FORBIDDEN.
4. NO OPINION OF TITLE OR OWNERSHIP IS HEREBY EXPRESSED OR IMPLIED BY THE SURVEYOR.
5. THIS SURVEY WAS PREPARED FROM INFORMATION FURNISHED TO THE SURVEYOR BY THE CLIENT, AND MAY BE SUBJECT TO EASEMENTS OR LIMITATIONS EITHER RECORDED OR IMPLIED.
6. BEARINGS ARE BASED ON ASSUMED DATUM AND ON THE LINE SHOWN AS BEING THE BASIS OF BEARINGS
7. NO UNDERGROUND IMPROVEMENTS HAVE BEEN LOCATED UNLESS OTHERWISE SHOWN.
8. ELEVATIONS, IF SHOWN, ARE BASED ON THE NATIONAL GEODETIC VERTICAL DATUM OF 1929, UNLESS OTHERWISE NOTED.

3970 MINTON ROAD, WEST MELBOURNE, FL 32904 L.B.#6623
PHONE: (321)768-8110 FAX: (321)952-9771 E-MAIL: aalsurvey@aalsurvey.com

ANDREW W. POWSHOK
P.L.S. No. 4383

LEGEND

(P) – PLAT
(M) – MEASURED
(D) – DEED
FND. – FOUND
I.R. – IRON ROD
I.P. – IRON PIPE
C.M. – CONCRETE MONUMENT
℄ – CENTERLINE
R/W – RIGHT OF WAY
P – PUBLIC
U – UTILITY
D – DRAINAGE
E – EASEMENT
FF – FINISH FLOOR
EL – ELEVATION
Δ – DELTA
R – RADIUS
L – ARC LENGTH
(B.B.) – BASIS OF BEARING
(N.R.) – NON RADIAL
N&D – NAIL AND DISK
CONC. – CONCRETE
ASPH. – ASPHALT
P.O.L. – POINT ON LINE
PRM – PERMANENT REFERENCE MARKER