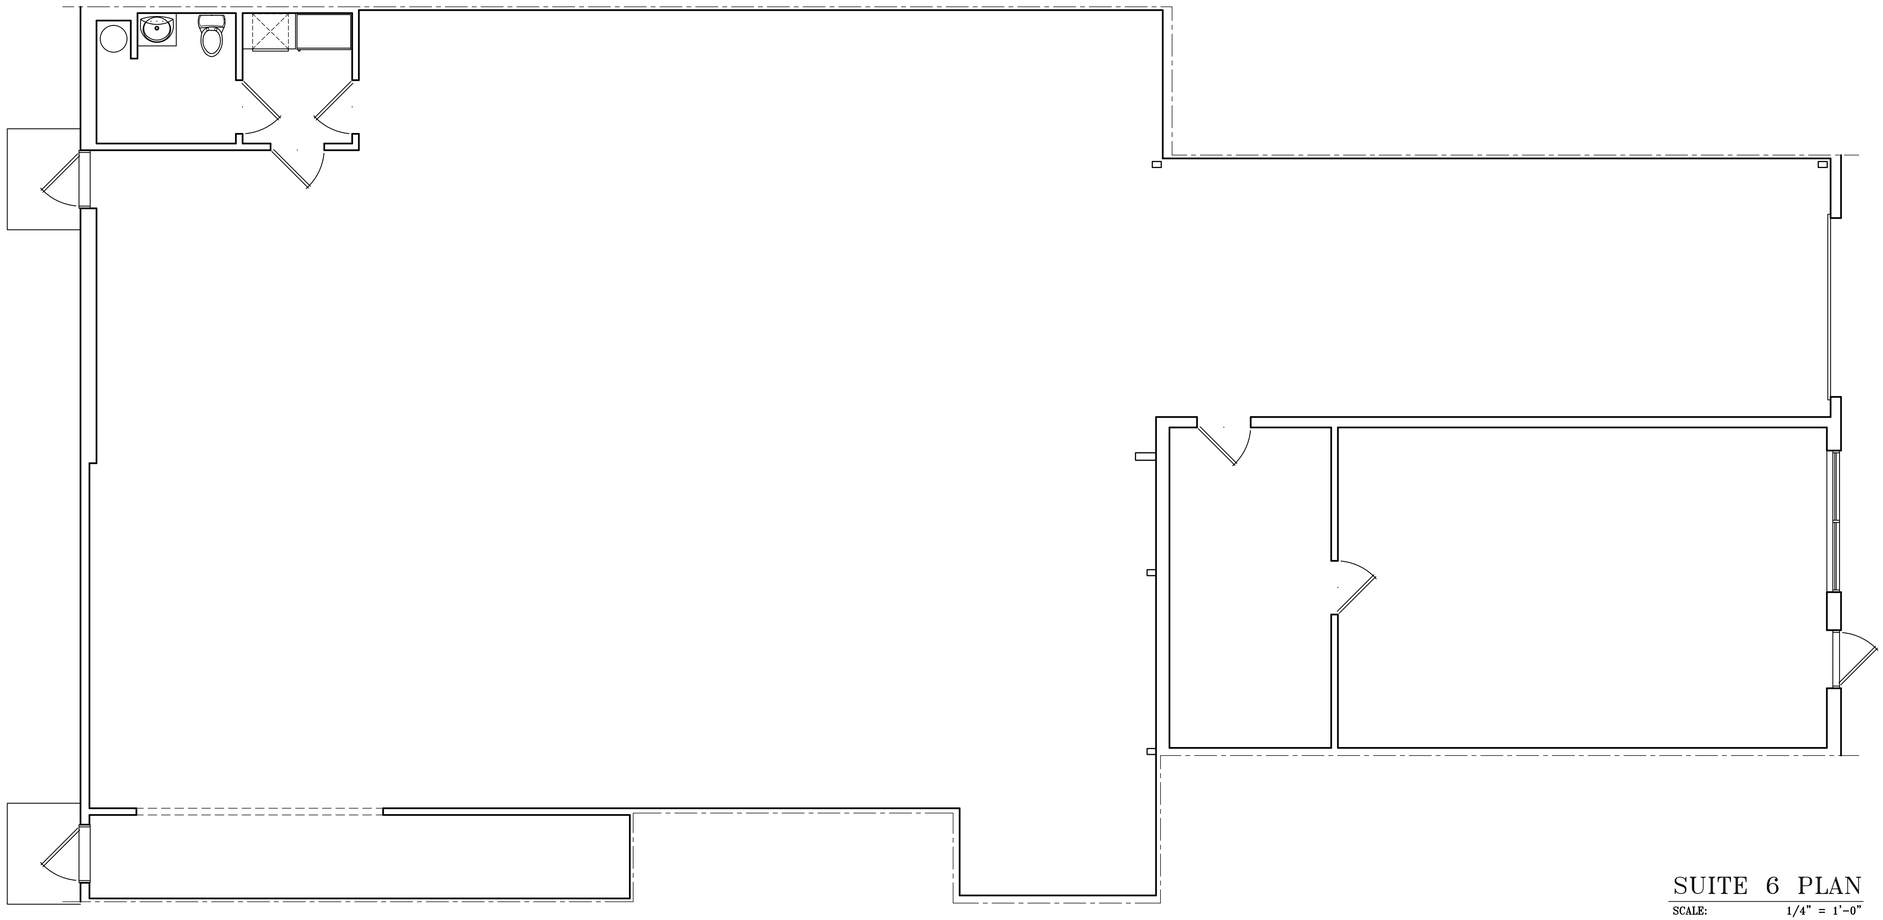

SUITE 6 PLAN

SCALE: 1/4" = 1'-0"

BUILDING AREA
SUITE 6 - 4,216 SQ. FT.

West & Associates
ARCHITECTS
4389 SHELBORNE DRIVE. DUNWOODY. GEORGIA 30338-6615 (770) 457-4495

DATE	REV.NO.	DESCRIPTION

SEAL

STATE OF GEORGIA
STEPHEN BLAINE WEST
CERTIFICATE NO. 4389
REGISTERED ARCHITECT

DRAWN	CHECKED	APPROVED

SHEET TITLE: SUITE 6 PLAN

PROJECT NAME: AS-BUILT SURVEY FOR 120 GLOSTER RD. - LAWRENCEVILLE, GA

REPRODUCTION RESTRICTION
This drawing is the property of the Architect and may not be copied or reproduced without the written permission of the Architect.

PROJECT NO.	DATE
2012110.00	6 OCT. 2024

SHEET NO.

A-6