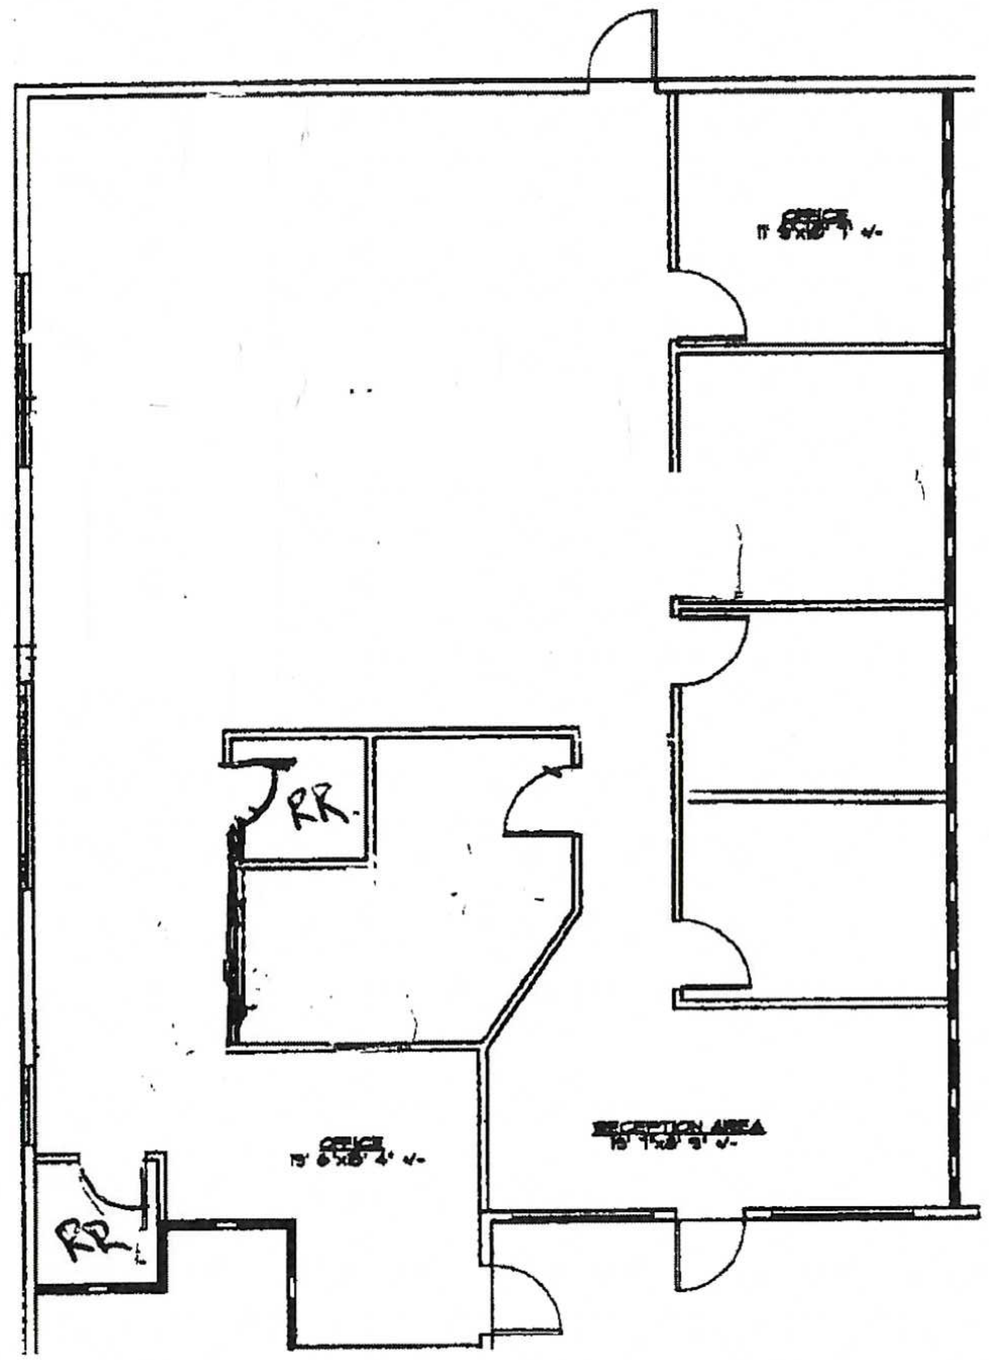

ISLAND LAKE CENTER
18897 STATE ROAD 434
LONGWOOD, FL 32750

2ND FLOOR
SUITE 228
2,198 □/ ±

AS-BUILT FLOOR PLAN
THIS IS NOT A SURVEY. ALL DIMENSIONS ARE NOMINAL AND SUBJECT TO FIELD VERIFICATION.

0 4' 8' 16'
1/8"=1'-0"

ISLAND DEVELOPMENT COMPANY
CHANTILLY COURT
8880 Mount Dora Rd., Suite C-200
Winter Park, FL 32789

AS-BUILT
FLOOR PLANS
NOT FOR CONSTRUCTION

228