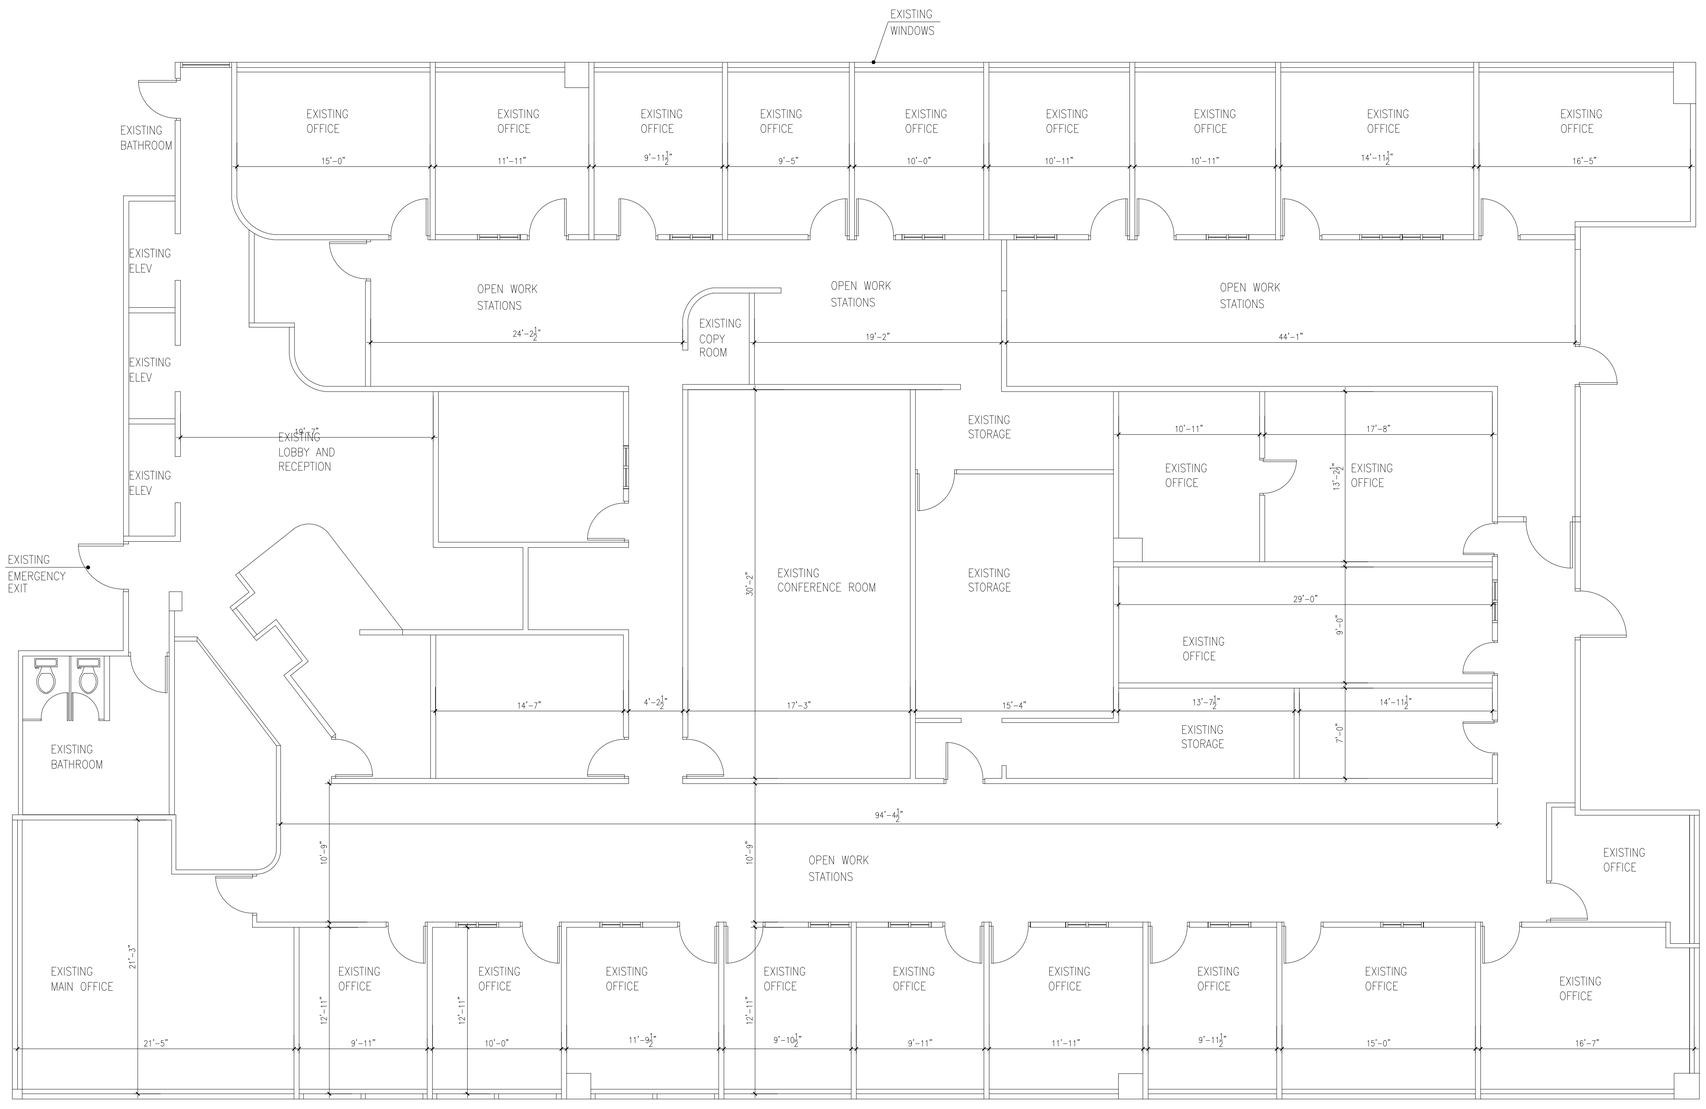

ED. CALLE BOLIVIA

MEASURED FLOOR PLAN DRAWING

SC: 3/16"=1'-0"

OFFICE N.	USABLE SQ FT	RENTABLE SQ FT
PISO 7	9,360.00	11,414.63

GENERAL NOTES:

1. THIS MEASURED DRAWINGS IS PROVIDED AS A REFERENCE DRAWING TO ILLUSTRATE EXISTING CONDITIONS OF A BUILDING INTO WHICH A FUTURE RENOVATION WILL BE INCORPORATED.
2. THIS MEASURED DRAWINGS SHOULD NOT BE CONSTRUCTED AS A COMPREHENSIVE RECORD OF ALL CONDITIONS THAT WILL IMPACT THIS BUILDING. NOR SHOULD IT BE UNDERSTOOD TO BE A COMPLETE INDICATION OF ALL EXISTING MATERIALS, STRUCTURAL SYSTEMS, ITEMS OR UTILITIES (MECHANICAL. PLUMBING OR ELECTRICAL).
3. IT IS THE CONTRACTOR'S RESPONSABILITY TO EXAMINE THE SITE TO CONFIRM AND VERIFY THE EXISTING CONDITIONS AND DETERMINE IF ANY ITEMS CAN BE USED (OR REUSED).
4. ALL DIMENSIONS WHEN SUCH IN PLAN ARE TO FACE OF FINISHED SURFACES, UNLESS OTHERWISE NOTED.
5. ALL DIMENSIONS AND CONDITIONS MUST BE FIELD VERIFIED AT THE JOB SITE.
6. SOME OF THE EXISTING WALLS ARE NOT PERPENDICULAR. THE EXISTING ALIGNMENT OF THE INTERIOR BUILDING WALLS SHOULD BE FIELD VERIFIED.