


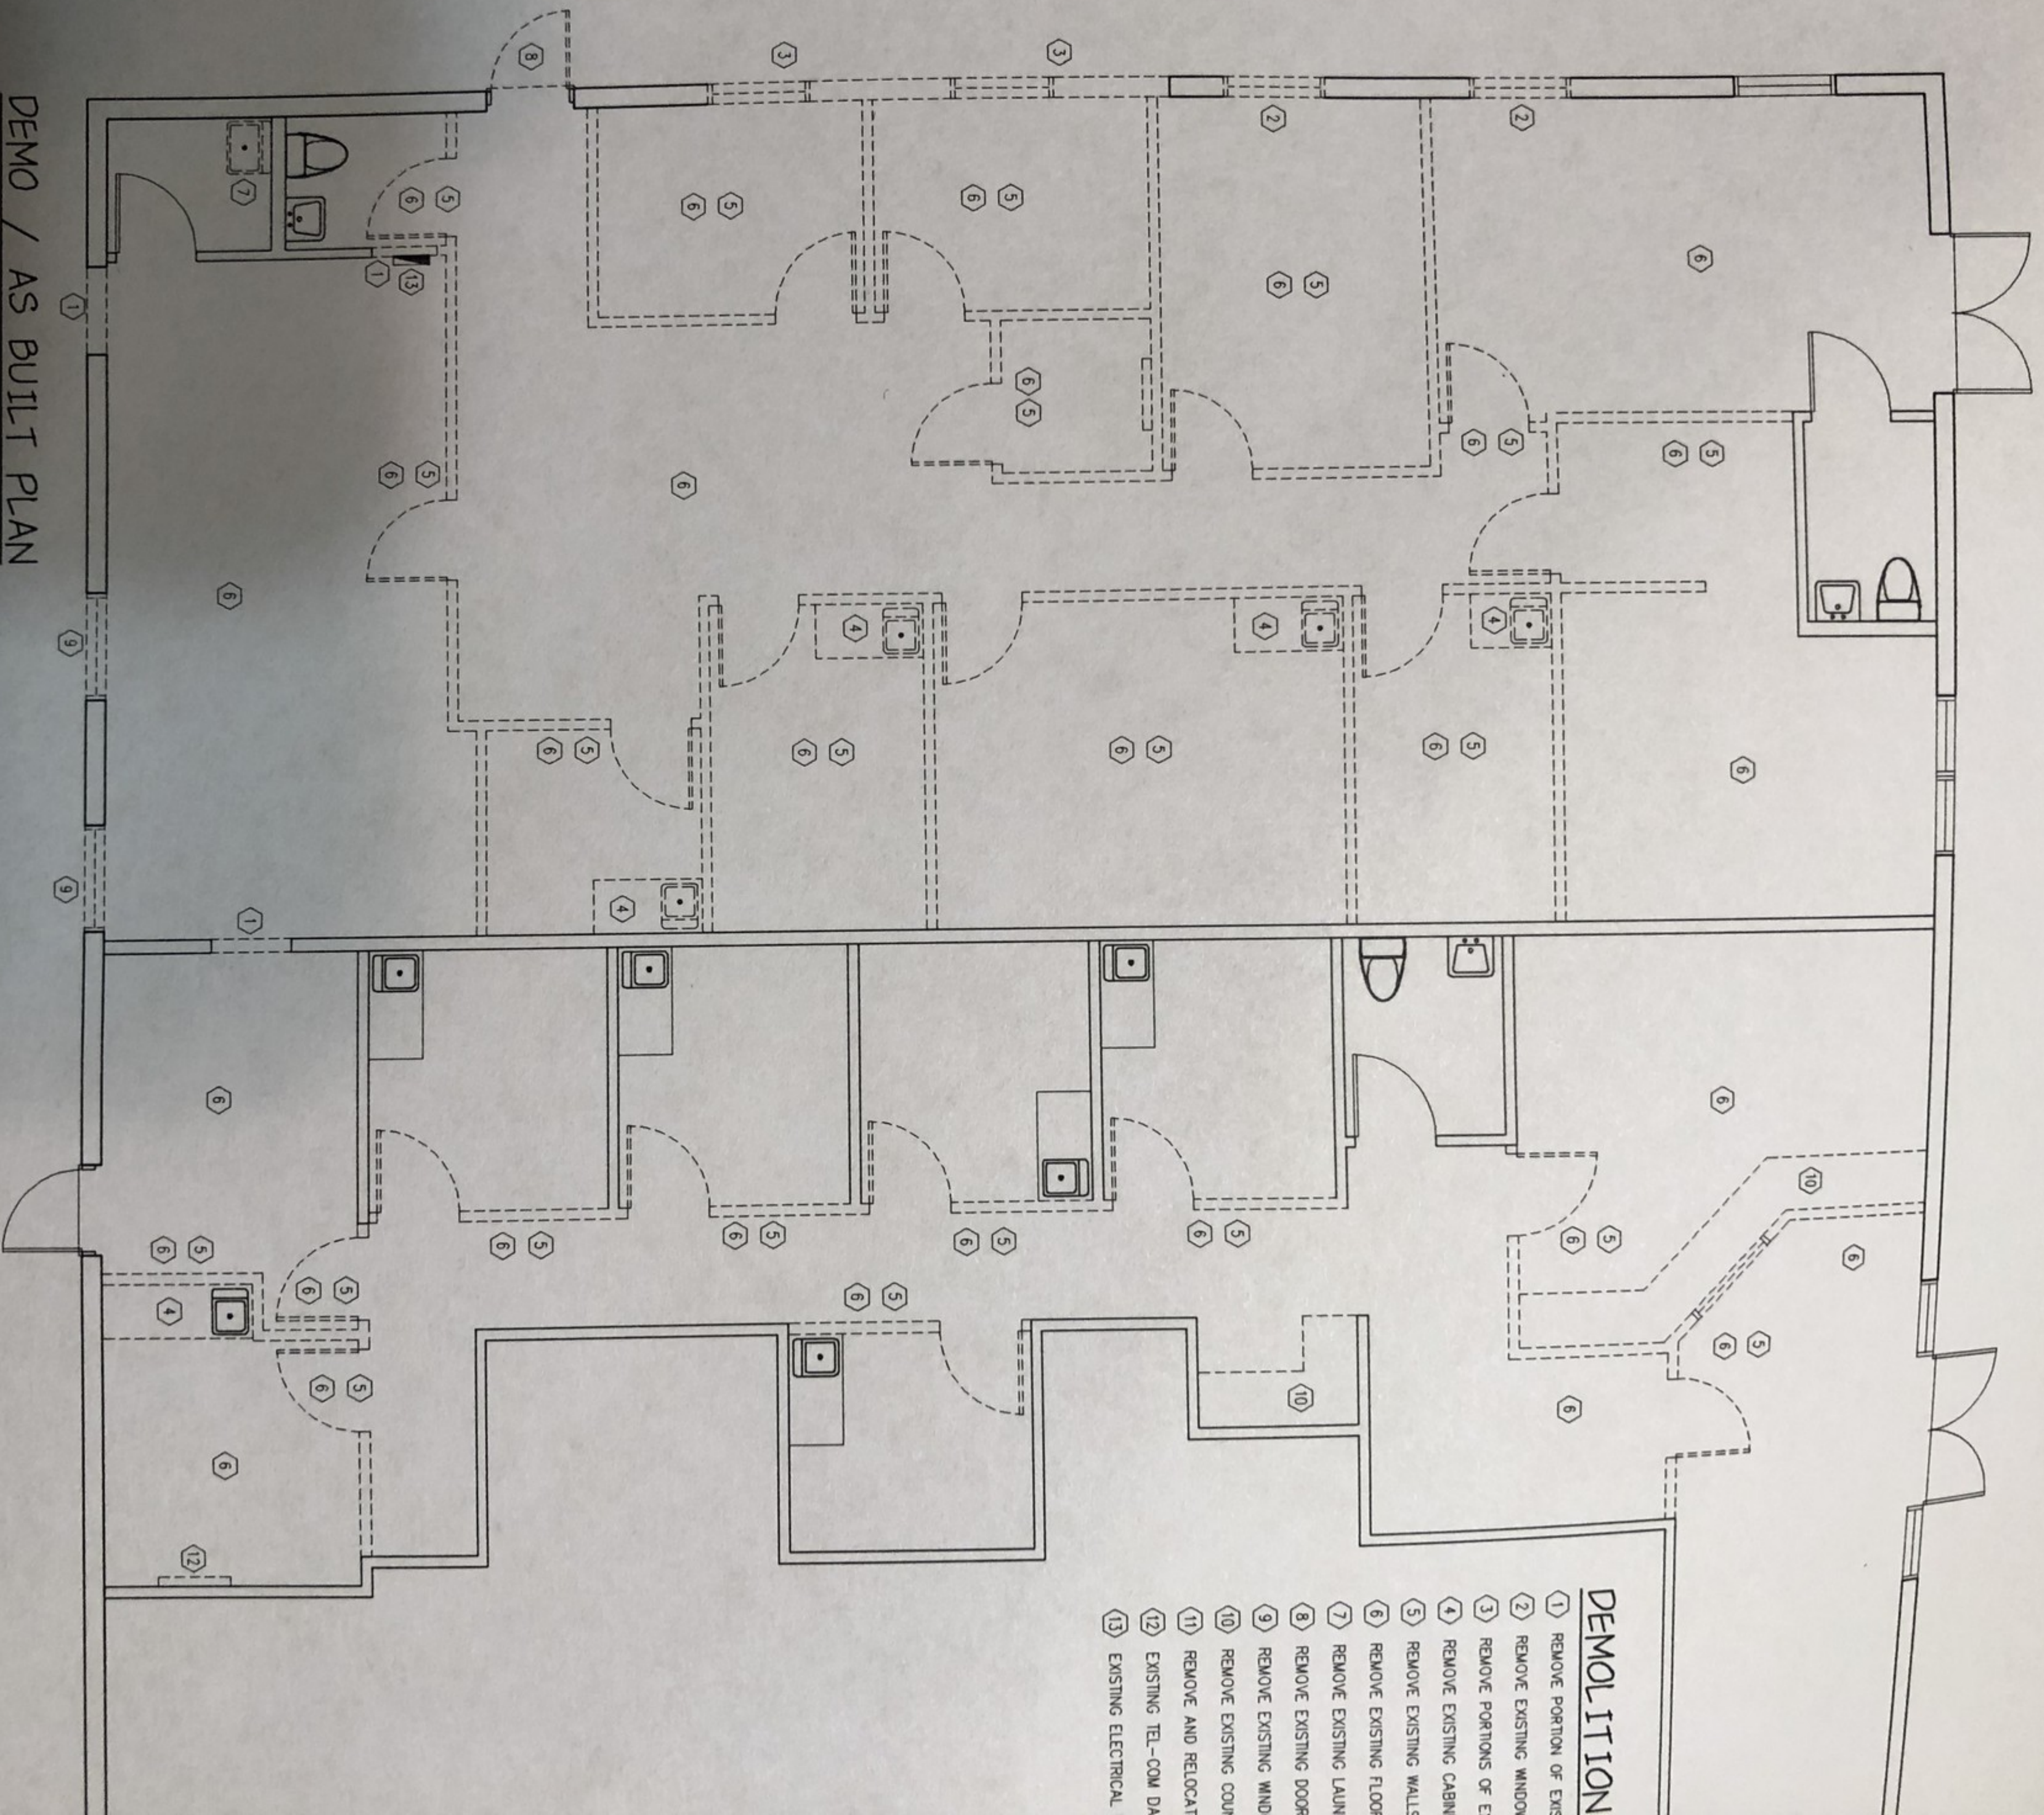

- ### DEMOLITION
- 1 REMOVE PORTION OF EXISTING WALL
 - 2 REMOVE EXISTING WINDOW
 - 3 REMOVE PORTIONS OF EXISTING WALL
 - 4 REMOVE EXISTING CABINETS
 - 5 REMOVE EXISTING WALLS
 - 6 REMOVE EXISTING FLOOR
 - 7 REMOVE EXISTING LAUNDRY
 - 8 REMOVE EXISTING DOOR
 - 9 REMOVE EXISTING WINDOW
 - 10 REMOVE EXISTING COUNTER
 - 11 REMOVE AND RELOCATE
 - 12 EXISTING TEL-COM DATA
 - 13 EXISTING ELECTRICAL

DEMO / AS BUILT PLAN

SCALE: 1/4" = 1'-0"