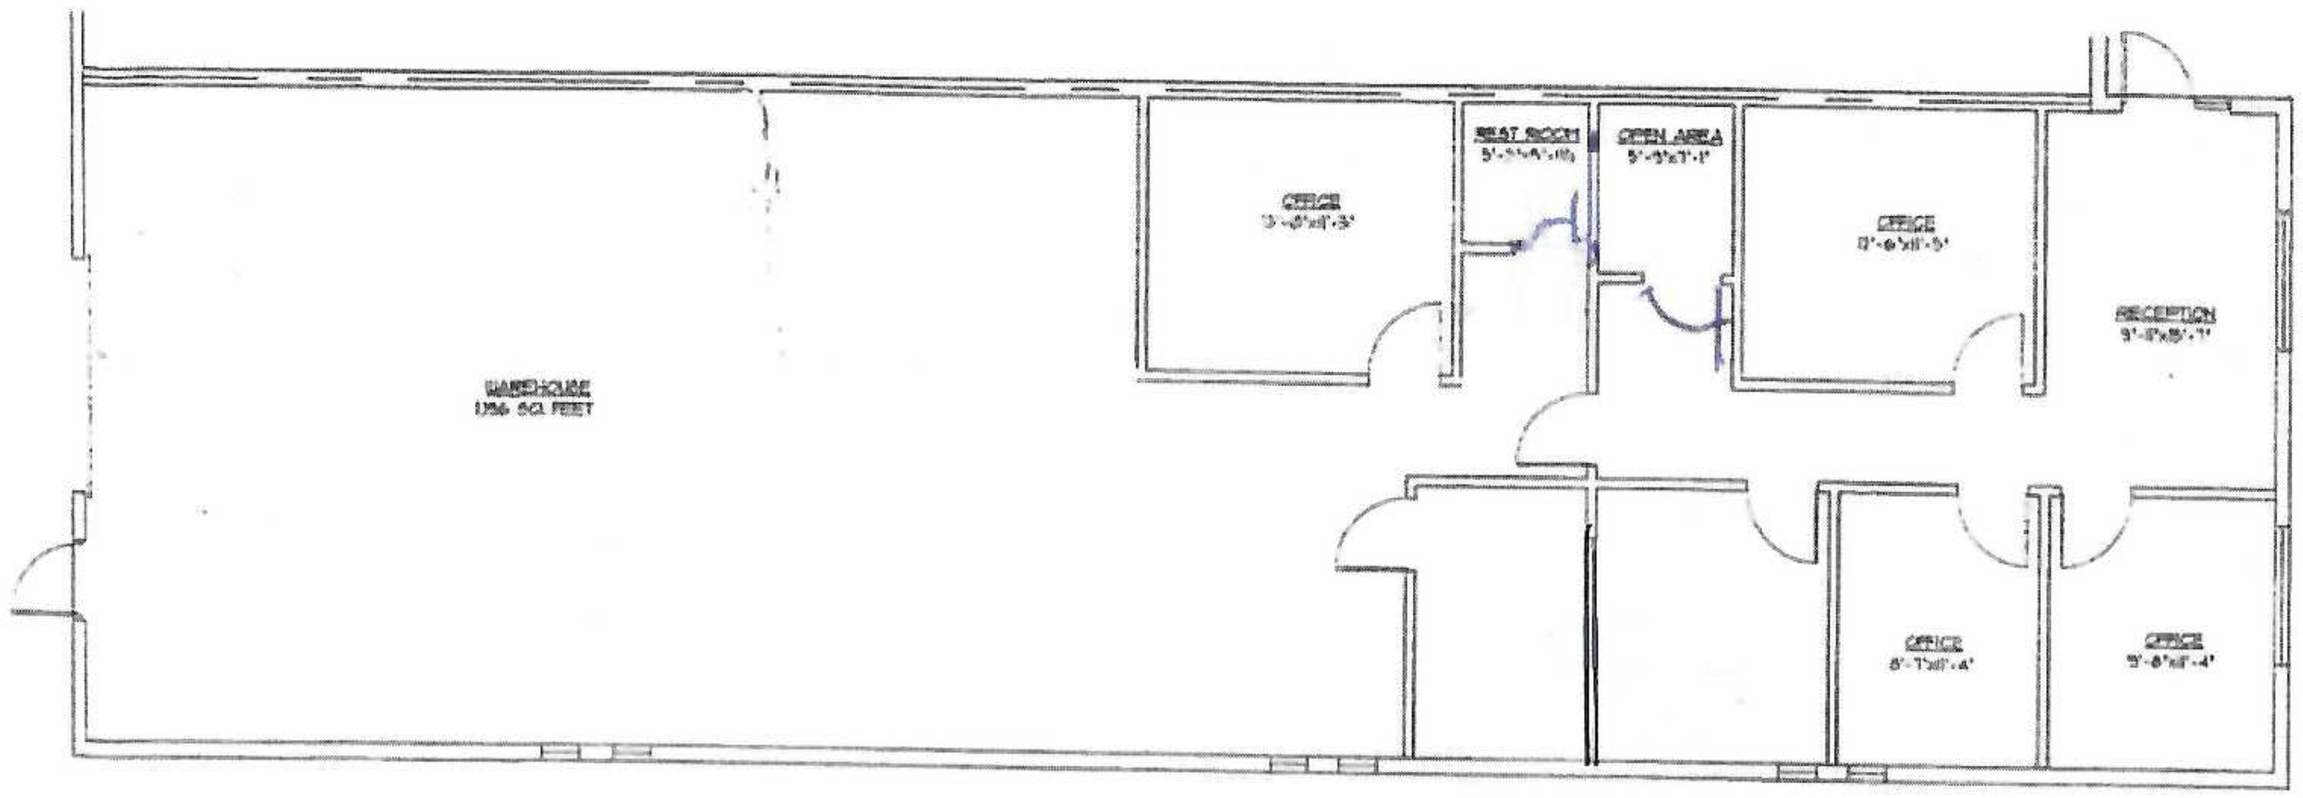



PARKE 33

4364 BARTLETT BOULEVARD
ORLANDO, FL 32811

26320

BUILDING I

SUITES 4364

2646 SQ. FEET

N

AS-BUILT FLOOR PLAN

THIS IS NOT A SURVEY. ALL DIMENSIONS ARE NOMINAL AND SUBJECT TO FIELD VERIFICATION.

BERLON & TAYLOR ARCHITECTS

KELLOGG DEVELOPMENT COMPANY

CHANTILLY COURT
9333 HOWELL BRANCH ROAD
WINTER PARK, FL 32789

AS-BUILT FLOOR PLANS

NOT FOR CONSTRUCTION

4364